

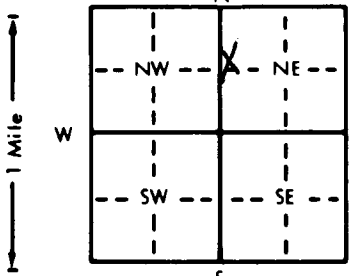
MW-8

2111024

WATER WELL RECORD

Form WWC-5

KSA 82a-1212

1 LOCATION OF WATER WELL:		Fraction	Section Number	Township Number	Range Number
County: <u>Sedgwick</u>		<u>SW 1/4 NW 1/4 NE 1/4</u>	<u>6</u>	T <u>28</u> S	R <u>1</u> <u>E/W</u>
Distance and direction from nearest town or city street address of well if located within city? <u>2464 S. Glenn, Truesdell Middle School</u>					
2 WATER WELL OWNER: RR#, St. Address, Box # : City, State, ZIP Code :					
<u>USD 259</u> <u>3850 N. Hydraulic</u> <u>Wichita KS 67219</u>					
Board of Agriculture, Division of Water Resources Application Number:					
3 LOCATE WELL'S LOCATION WITH AN "X" IN SECTION BOX:		4 DEPTH OF COMPLETED WELL: <u>18</u> ft. ELEVATION:			
If yes, mo/day/yr sample was submitted Water Well Disinfected? Yes <u>No</u> <u>X</u>			
5 TYPE OF BLANK CASING USED:					
1 Steel 3 RMP (SR) 5 Wrought iron 8 Concrete tile CASING JOINTS: Glued <u>Clamped</u>					
2 <u>PVC</u> 4 ABS 6 Asbestos-Cement 9 Other (specify below) Welded <u>Flush</u>					
Casing height above land surface <u>Flush</u> in., weight <u>703</u> lbs./ft. Wall thickness or gauge No. <u>154</u>					
TYPE OF SCREEN OR PERFORATION MATERIAL:					
1 Steel 3 Stainless steel 5 Fiberglass 8 RMP (SR) 10 Asbestos-cement					
2 Brass 4 Galvanized steel 6 Concrete tile 9 ABS 11 Other (specify)					
12 None used (open hole)					
SCREEN OR PERFORATION OPENINGS ARE:					
1 Continuous slot 3 <u>Mill slot</u> 5 Gauzed wrapped 8 Saw cut 11 None (open hole)					
2 Louvered shutter 4 Key punched 6 Wire wrapped 9 Drilled holes					
7 Torch cut 10 Other (specify)					
SCREEN-PERFORATED INTERVALS: From <u>8</u> ft. to <u>18</u> ft., 
6 GROUT MATERIAL:					
1 Neat cement 2 Cement grout 3 <u>Bentonite</u> 4 Other					
Grout Intervals: From <u>7</u> ft. to <u>1</u> ft., 
What is the nearest source of possible contamination:					
1 Septic tank 4 Lateral lines 7 Pit privy 10 Livestock pens 14 Abandoned water well					
2 Sewer lines 5 Cess pool 8 Sewage lagoon 11 <u>Fuel storage</u> 15 Oil well/Gas well					
3 Watertight sewer lines 6 Seepage pit 9 Feedyard 12 Fertilizer storage 16 Other (specify below)					
13 Insecticide storage					
Direction from well? <u>NE</u> How many feet? <u>200</u>					
FROM		TO		LITHOLOGIC LOG	
FROM		TO		PLUGGING INTERVALS	
0.0		2.0		Top soil	
2.0		8.5		Clay, silty	
8.5		12.0		Sand, very fine to fine	
12.0		14.0		Sand, medium to coarse	
14.0		18.0		Coarse sand & gravel	
7 CONTRACTOR'S OR LANDOWNER'S CERTIFICATION: This water well was <u>(1) constructed</u> (2) reconstructed, or (3) plugged under my jurisdiction and was completed on (mo/day/year) <u>10-6-93</u> and this record is true to the best of my knowledge and belief. Kansas Water Well Contractor's License No. <u>531</u> This Water Well Record was completed on (mo/day/yr) <u>10-8-93</u> under the business name of <u>GSI</u> by (signature) <u>Allison J. J. J.</u>					
INSTRUCTIONS: Use typewriter or ball point pen. PLEASE PRESS FIRMLY and PRINT clearly. Please fill in blanks, underline or circle the correct answers. Send top three copies to Kansas Department of Health and Environment, Bureau of Water, Topeka, Kansas 66620-0001. Telephone: 913-296-5545. Send one to WATER WELL OWNER and retain one for your records.					