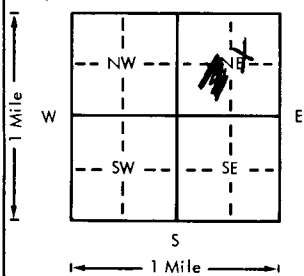


USE TYPEWRITER OR BALL
POINT PEN-PRESS FIRMLY,
PRINT CLEARLY.

WATER WELL RECORD
KSA 82a-1201-1215

Kansas Department of Health and
Environment-Division of Environment
(Water well Contractors)
Topeka, Kansas 66620

1. Location of well:		County Sedgwick	Fraction SW 1/4 NE 1/4 NE 1/4	Section number 7	Township number T 28	Range number S R 1E	E/W
2. Distance and direction from nearest town or city: Street address of well location if in city: 1219 W. Patterson				3. Owner of well: DAVID DELANEY R.R. or street: 1219 W. PATTERSON City, state, zip code: WICHITA, KANS.			
4. Locate with "X" in section below:		Sketch map: X		6. Bore hole dia. 11 in. Completion date: 3-17-79 Well depth 23 ft.			
				7. Cable tool ☐ Rotary ☐ Driven ☐ Dug ☐ Hollow rod ☐ Jetted ☒ Bored ☐ Reverse rotary ☐			
5. Type and color of material		From		To		8. Use: Domestic ☐ Public supply ☐ Industry ☐ Irrigation ☐ Air conditioning ☐ Stock ☐ ☒ Lawn ☐ Oil field water ☐ Other ☐	
Topsoil		0		10		9. Casing: Material PVC Height: Above or below Threaded ☐ Welded ☐ Surface 12 in. RMP ☐ PVC ☒ Weight 2.558 lbs./ft. Dia. 5 in. to 23 ft. depth Wall Thickness: inches or Dia. ☐ in. to ☐ ft. depth Gage No. 258	
Sand fine		11		15		10. Screen: Manufacturer's name Wichita Type PVC Dia. 5.363 Slot/gauze .025 Length 5' Set between 18 ft. and 23 ft. ft. and ft. Gravel pack? NO Size range of material	
Sand-medium		16		23		11. Static water level: mo./day/yr. 15 ft. below land surface Date 3-17-79	
						12. Pumping level below land surfaces: 15 ft. after 1 hrs. pumping 15 g.p.m. ft. after hrs. pumping g.p.m. Estimated maximum yield 50 g.p.m.	
						13. Water sample submitted: mo./day/yr. Yes ☐ No ☒ Date	
						14. Well head completion: Pitless adapter 12 inches above grade	
						15. Well grouted? YES With: Neat cement Bentonite ☐ Concrete ☐ Depth: From 0 ft. to 10 ft.	
						16. Nearest source of possible contamination: ft. 25 Direction N Type SEWER Well disinfected upon completion? ☒ Yes ☐ No	
						17. Pump: ☒ Not installed Manufacturer's name Model number HP Volts Length of drop pipe ft. capacity g.p.m. Type: ☐ Submersible ☐ Turbine ☐ Jet ☐ Reciprocating ☐ Centrifugal ☐ Other	
18. Elevation:		19. Remarks:		20. Water well contractor's certification: This well was drilled under my jurisdiction and this report is true to the best of my knowledge and belief. 21st Electric Business name 512 W. 21st License No. 129 Address J. Harris Date 3-21-79 Signed J. Harris Authorized representative			

Forward the white, blue and pink copies to the Department of Health and Environment

Form WWC-5