USE TYPEWRITER OR BALL POINT PEN-PRESS FIRMLY, PRINT CLEARLY.

WATER WELL RECORD
KSA 82a-1201-1215

Kansas Department of Health and Environment-Division of Environment
(Water well Contractors)
Topeka, Kansas 66620

1. Location of well: County: SEDGWICK | Fraction: 1/4 SW 1/4 NE 1/4 | Section number: 7 | Township number: T 28S | Range number: R 1 E/W

2. Distance and direction from nearest town or city:
Street address of well location if in city: 1430 W. 34th So. WICHITA, KANS.

3. Owner of well: JAMES SUMMERS
R.R. or street: 1430 WEST 34 SOUTH
City, state, zip code: WICHITA, KANSAS

4. Locate with "X" in section below: Sketch map:

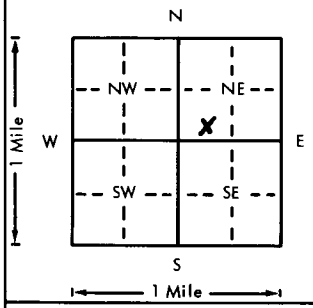

6. Bore hole dia. 11 in. Completion date
Well depth 40 ft. 5-21-76

7. Cable tool ✓ Rotary Driven Dug
Hollow rod Jetted Bored Reverse rotary

8. Use: Domestic Public supply Industry
Irrigation Air conditioning Stock
✓ Lawn Oil field water Other

9. Casing: Material STYRENE Height: (Above) or below
Threaded Welded ✓ Surface 12 in.
RMP ✓ PVC Weight lbs./ft.
Dia. 5 in. to 40 ft. depth Wall Thickness: inches or
Dia. in. to ft. depth gage No. 200

5. Type and color of material	From	To
TOPSOIL	0	2
SANDY SOIL	2	15
FINE SAND	15	20
COARSE SAND AND FINE - GRAVEL	20	40

(Use a second sheet if needed)

10. Screen: Manufacturer's name SUNFLOWER PLASTIC
Type STYRENE Dia. 5"
Slot/gauze .06 Length 10'
Set between 30 ft. and 40 ft.
ft. and ft.
Gravel pack? YES Size ronge of material 1/4 - 16 "

11. Static water level: mo./day/yr.
15 ft. below land surface Date 5-21-76

12. Pumping level below lond surfaces:
ft. after hrs. pumping g.p.m.
ft. after hrs. pumping g.p.m.
Estimated maximum yield g.p.m.

13. Water sample submitted: mo./day/yr.
Yes No Date

14. Well head completion: CAPPED
Pitless adapter 12 Inches above grade

15. Well grouted? YES
With: Neat cement Bentonite ✓ Concrete
Depth: From 40' to 14 ft.

16. Nearest source of possible contamination: CITY
ft. 50 Direction 50. Type SEWER
Well disinfected upon completion? ✓ Yes No

17. Pump: ✓ Not installed
Manufacturer's name
Model number HP Volts
Length of drop pipe ft. capacity g.p.m.
Type:
Submersible Turbine
Jet Reciprocating
Centrifugal Other

18. Elevation:
Topography:
Hill
Slope
Upland
Valley

19. Remarks: FLAT GROUND

20. Water well contractor's certification:
This well was drilled under my jurisdiction and this report is true to the best of my knowledge and belief.
HARP WELL + PUMP 236
Business name License No.
Address WICHITA, KANSAS
Signed M. Arnold, Date
Authorized representative 8-18-76

28 T 1 R E/W 7 Sec SW 1/4 1/4 1/4

Forward the white, blue and pink copies to the Department of Health and Environment

Form WWC-5

MI-1023