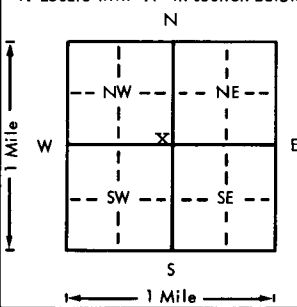


USE TYPEWRITER OR BALL
POINT PEN-PRESS FIRMLY,
PRINT CLEARLY.

WATER WELL RECORD
KSA 82a-1201-1215

Kansas Department of Health and
Environment-Division of Environment
(Water well Contractors)
Topeka, Kansas 66620

1. Location of well:		County Sedgwick	Fraction SW SW SW NE 1/4 1/4 1/4 1/4	Section number 8	Township number T 28 S	Range number R 1E E/W
2. Distance and direction from nearest town or city: Street address of well location if in city: 524 West 35th South Wichita, Kansas			3. Owner of well: Don George R.R. or street: 524 West 35th Street South City, state, zip code: Wichita, Kansas			
4. Locate with "X" in section below: 			Sketch map:		6. Bore hole dia. 11 in. Completion date 6-10-77 Well depth 60 ft.	
5. Type and color of material			From	To	7. ☒ Cable tool ☒ Rotary ☐ Driven ☐ Dug ☐ Hollow rod ☐ Jetted ☐ Bored ☐ Reverse rotary	
					8. Use: ☐ Domestic ☐ Public supply ☐ Industry ☐ Irrigation ☐ Air conditioning ☐ Stock ☒ Lawn ☐ Oil field water ☐ Other	
					9. Casing: Material Styrene Height: Above or below 111 Threaded ☐ Welded ☒ Surface 12 in. RMP ☒ PVC ☐ Weight 12 lbs./ft. Dia. 5 in. to 60 ft. depth Wall Thickness: inches or Dia. 5 in. to 60 ft. depth gage No. 200	
					10. Screen: Manufacturer's name Sunflower Plastic Type Styrene Dia. 5" Slot/gauge .06 Length 20' Set between 40 ft. and 60 ft. ft. and 1/2-1/8" Gravel pack ☒ yes Size range of material 1/4-1/8"	
					11. Static water level: 30 ft. below land surface Date 6-10-77 mo./day/yr.	
					12. Pumping level below land surfaces: ft. after hrs. pumping g.p.m. ft. after hrs. pumping g.p.m. Estimated maximum yield g.p.m.	
					13. Water sample submitted: 12 mo./day/yr. Yes ☐ No ☒ Date	
					14. Well head completion: Capped Pitless adapter 12 inches above grade	
					15. Well grouted? yes to 2 fine sand m.x. With: ☐ Neat cement ☐ Bentonite ☒ Concrete Depth: From 40" ft. to 14 ft.	
					16. Nearest source of possible contamination: Septic ft. 100 Direction North Type Tank Well disinfected upon completion? ☒ Yes ☐ No	
(Use a second sheet if needed)					17. Pump: ☒ Not installed Manufacturer's name Model number HP Volts Length of drop pipe ft. capacity g.p.m. Type: ☐ Submersible ☐ Turbine ☐ Jet ☐ Reciprocating ☐ Centrifugal ☐ Other	
18. Elevation: Topography: ☐ Hill ☒ Slope ☐ Upland ☐ Valley	19. Remarks:		20. Water well contractor's certification: This well was drilled under my jurisdiction and this report is true to the best of my knowledge and belief. Harp Well & Pump 236 Business name License No. Address Wichita, Kansas Signed M. Arnold Date 8-4-77 Authorized representative			

Forward the white, blue and pink copies to the Department of Health and Environment

Form WWC-5