



$\frac{1}{4}$

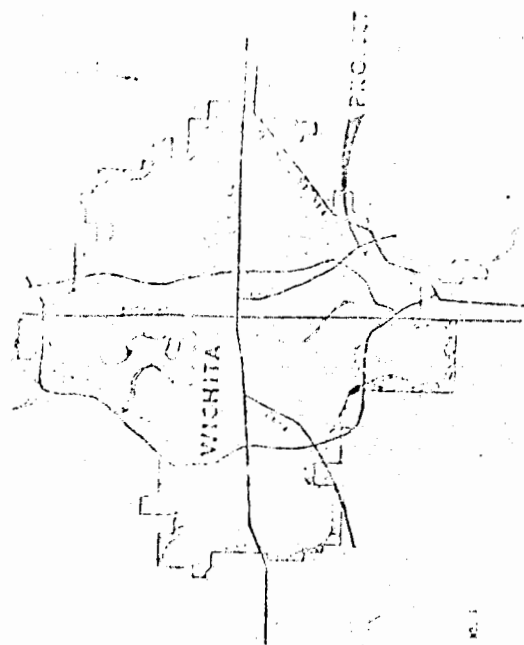

LOCATION MAP




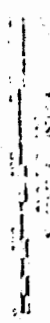

WICHITA, KANSAS
 SHEET NO. 1

WILSON
 COMPANY
 ENGINEERS &
 ARCHITECTS

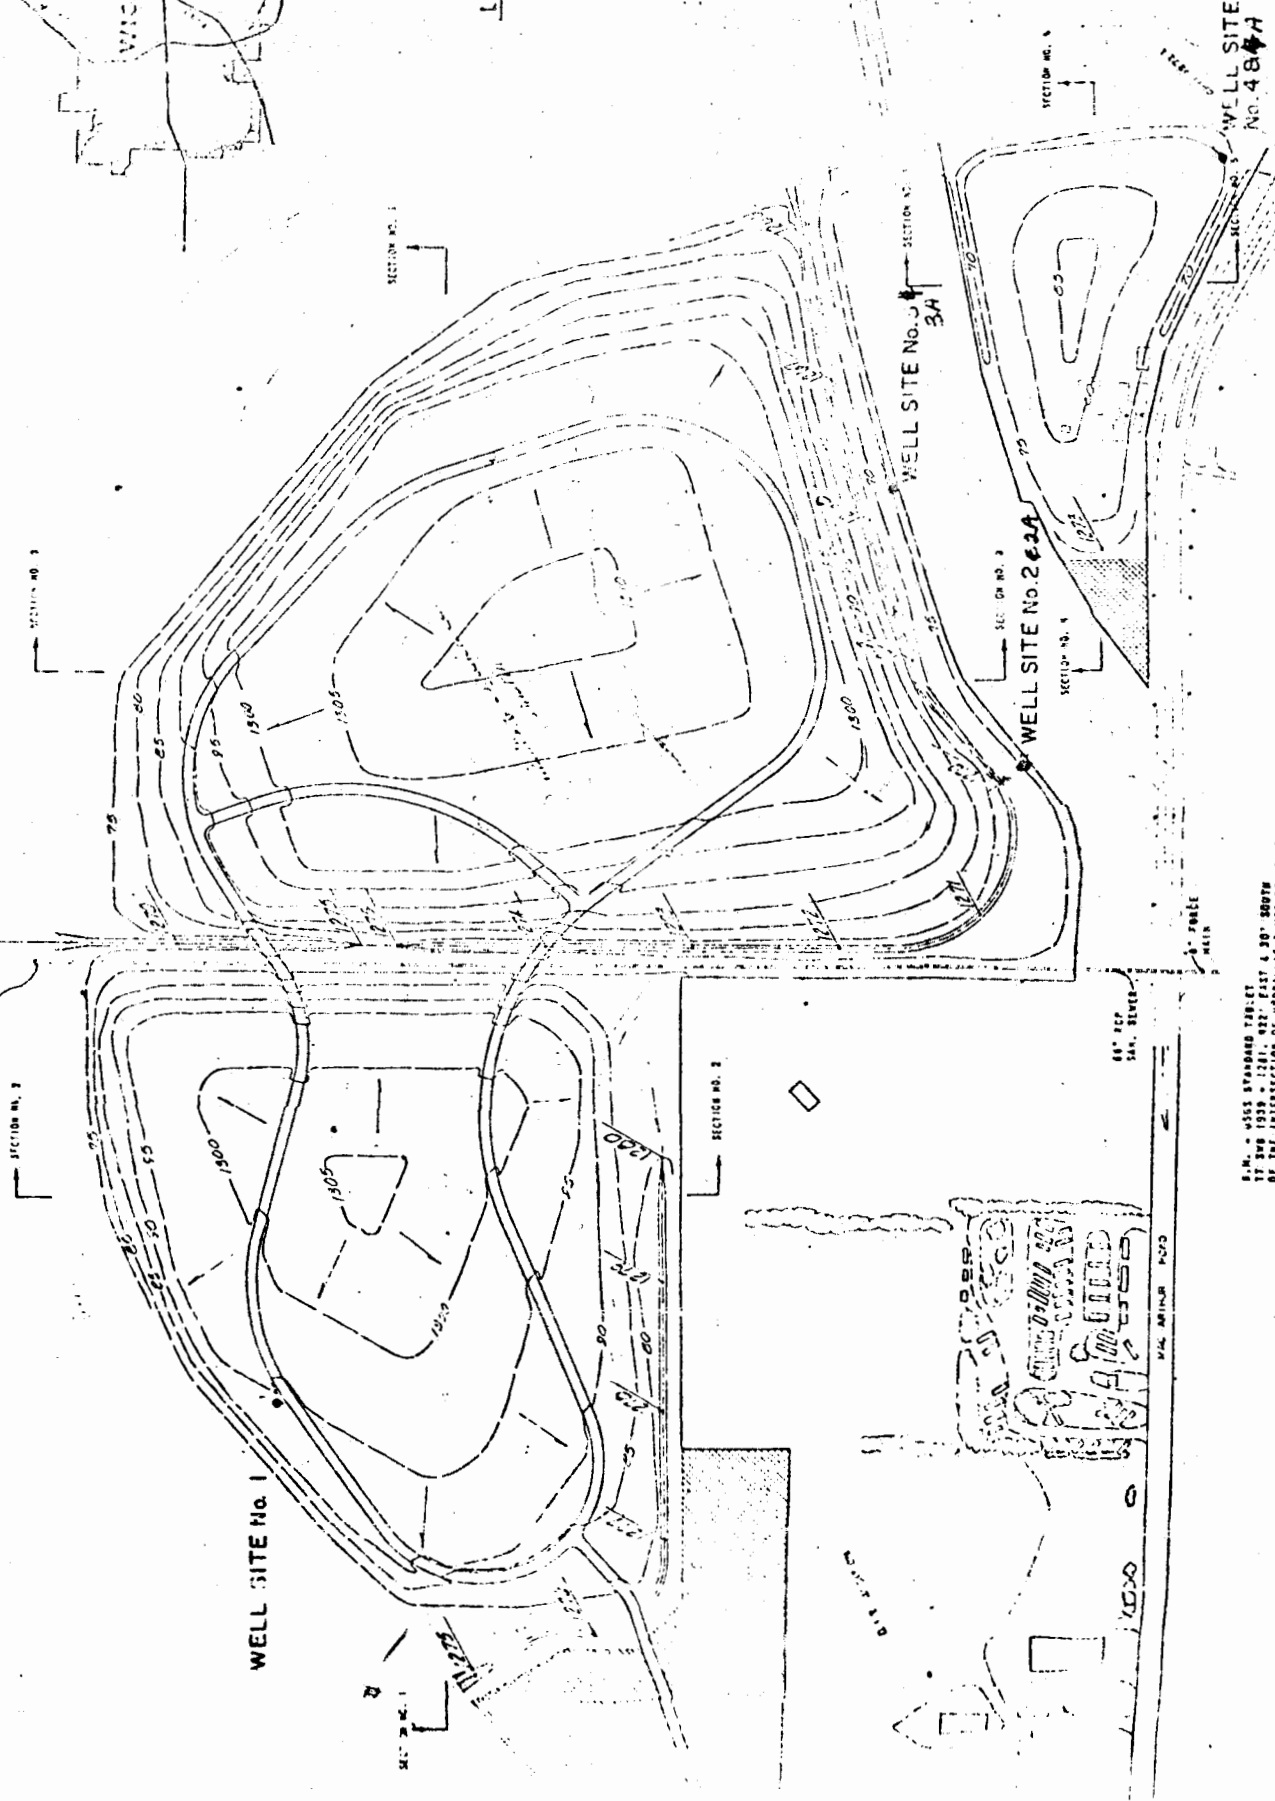

S.M. - 1955 STANDARD TABLE
 17 248 1939 - 1281. 422' EAST 4 30' SOUTH
 OF THE INTERSECTION OF AERIALIC & MACARTHUR ST.
 E.L. 1281.007