

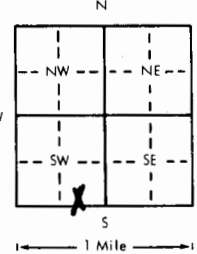
 
 


1 LOCATION OF WATER WELL County: <u>SEDGWICK</u>		Fraction <u>X</u> SW $\frac{1}{4}$ SE $\frac{1}{4}$ SW $\frac{1}{4}$	Section Number <u>10</u>	Township Number T <u>28</u> S	Range Number R <u>1E</u> E4X		
Distance and direction from nearest town or city?			Street address of well if located within city? Well # <u>4</u> <u>3800 S. Hydraulic</u> <u>Wichita, Kansas</u>				
2 WATER WELL OWNER: RR#, St. Address, Box # : City, State, ZIP Code		City of Wichita <u>455 N. Main</u> <u>Wichita, Kansas</u>					
		Board of Agriculture, Division of Water Resources Application Number:					
3 DEPTH OF COMPLETED WELL... <u>25</u> ft. Bore Hole Diameter... <u>1.1</u> in. to ... ft., and ... in. to ... ft.							
Well Water to be used as: 1 Domestic 3 Feedlot 5 Public water supply 8 Air conditioning 11 Injection well 2 Irrigation 4 Industrial 6 Oil field water supply 9 Dewatering 12 Other (Specify below) 7 Lawn and garden only <u>10 Observation well</u>							
Well's static water level ... <u>15</u> ft. below land surface measured on ... <u>6</u> month ... <u>20</u> day ... <u>1979</u> year							
Pump Test Data : Well water was ... ft. after ... hours pumping ... gpm Est. Yield gpm: Well water was ... ft. after ... hours pumping ... gpm							
4 TYPE OF BLANK CASING USED: 1 Steel <u>3 RMP (SR)</u> 5 Wrought iron 8 Concrete tile Casing Joints: Glued <u>X</u> Clamped 2 PVC 4 ABS 6 Asbestos-Cement 9 Other (specify below) Welded 7 Fiberglass Threaded							
Blank casing dia ... <u>5</u> in. to ... <u>15</u> ft. Dia ... in. to ... ft. Dia ... in. to ... ft.							
Casing height above land surface ... <u>1.2</u> in., weight ... lbs./ft. Wall thickness or gauge No. <u>250</u>							
TYPE OF SCREEN OR PERFORATION MATERIAL: 1 Steel 3 Stainless steel 5 Fiberglass <u>8 RMP (SR)</u> 10 Asbestos-cement 2 Brass 4 Galvanized steel 6 Concrete tile <u>9 ABS</u> 11 Other (specify) 12 None used (open hole)							
Screen or Perforation Openings Are: 1 Continuous slot 3 Mill slot 5 Gauzed wrapped <u>8 Saw cut .06</u> 11 None (open hole) 2 Louvered shutter 4 Key punched 6 Wire wrapped <u>9 Drilled holes</u> 7 Torch cut 10 Other (specify)							
Screen-Perforation Dia ... <u>5</u> in. to ... <u>25</u> ft. Dia ... in. to ... ft. Dia ... in. to ... ft.							
Screen-Perforated Intervals: From ... <u>15</u> ft. to ... <u>25</u> ft. From ... ft. to ... ft. From ... ft. to ... ft.							
Gravel Pack Intervals: From ... <u>14 1/2</u> ft. to ... <u>25</u> ft. From ... ft. to ... ft. From ... ft. to ... ft.							
5 GROUT MATERIAL: 1 Neat cement <u>2 Cement grout</u> 3 Bentonite 4 Other							
Grouted Intervals: From ... <u>0</u> ft. to ... <u>14 1/2</u> ft. From ... ft. to ... ft. From ... ft. to ... ft.							
What is the nearest source of possible contamination: <u>All monitor wells are at</u> 10 Fuel storage 14 Abandoned water well 1 Septic tank 4 Cess pool edge of City Sewage lagoon 11 Fertilizer storage 15 Oil well/Gas well 2 Sewer lines 5 Seepage pit Landfill. 8 Feed yard 12 Insecticide storage <u>16 Other (specify below)</u> 3 Lateral lines 6 Pit privy 9 Livestock pens 13 Watertight sewer lines							
Direction from well ... How many feet ... ? Water Well Disinfected? Yes <u>X</u> No							
Was a chemical/bacteriological sample submitted to Department? Yes No <u>X</u> If yes, date sample was submitted ... month ... day ... year: Pump Installed? Yes No <u>X</u>							
If Yes: Pump Manufacturer's name ... Model No. ... HP Volts ...							
Depth of Pump Intake ... ft. Pumps Capacity rated at ... gal./min.							
Type of pump: 1 Submersible 2 Turbine 3 Jet 4 Centrifugal 5 Reciprocating 6 Other							
6 CONTRACTOR'S OR LANDOWNER'S CERTIFICATION: This water well was (1) <u>constructed</u> , (2) reconstructed, or (3) plugged under my jurisdiction and was completed on ... <u>6</u> month ... <u>20</u> day ... <u>1979</u> year							
and this record is true to the best of my knowledge and belief. Kansas Water Well Contractor's License No. <u>236</u>							
This Water Well Record was completed on ... <u>7</u> month ... <u>25</u> day ... <u>1979</u> year under the business name of <u>Harp Well & Pump Service, Inc.</u> by (signature) <u>M. Arnold</u>							
7 LOCATE WELL'S LOCATION WITH AN "X" IN SECTION BOX:		FROM	TO	LITHOLOGIC LOG	FROM	TO	LITHOLOGIC LOG
		0	3	Topsoil			
		3	6	Fine Sand			
		6	8	Clay			
		8	15	Fine Sand			
		15	25	Medium Sand			
ELEVATION: <u>Flat Ground</u>							
Depth(s) Groundwater Encountered		1	2	3	4	(Use a second sheet if needed)	

INSTRUCTIONS: Use typewriter or ball point pen, please press firmly and PRINT clearly. Please fill in blanks, underline or circle the correct answers. Send top three copies to Kansas Department of Health and Environment, Division of Environment, Water Well Contractors, Topeka, KS 66620. Send one to WATER WELL OWNER and retain one for your records.

 

WILSON
& COMPANY
ENGINEERS &
ARCHITECTS
1004 10th

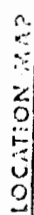