


1/4

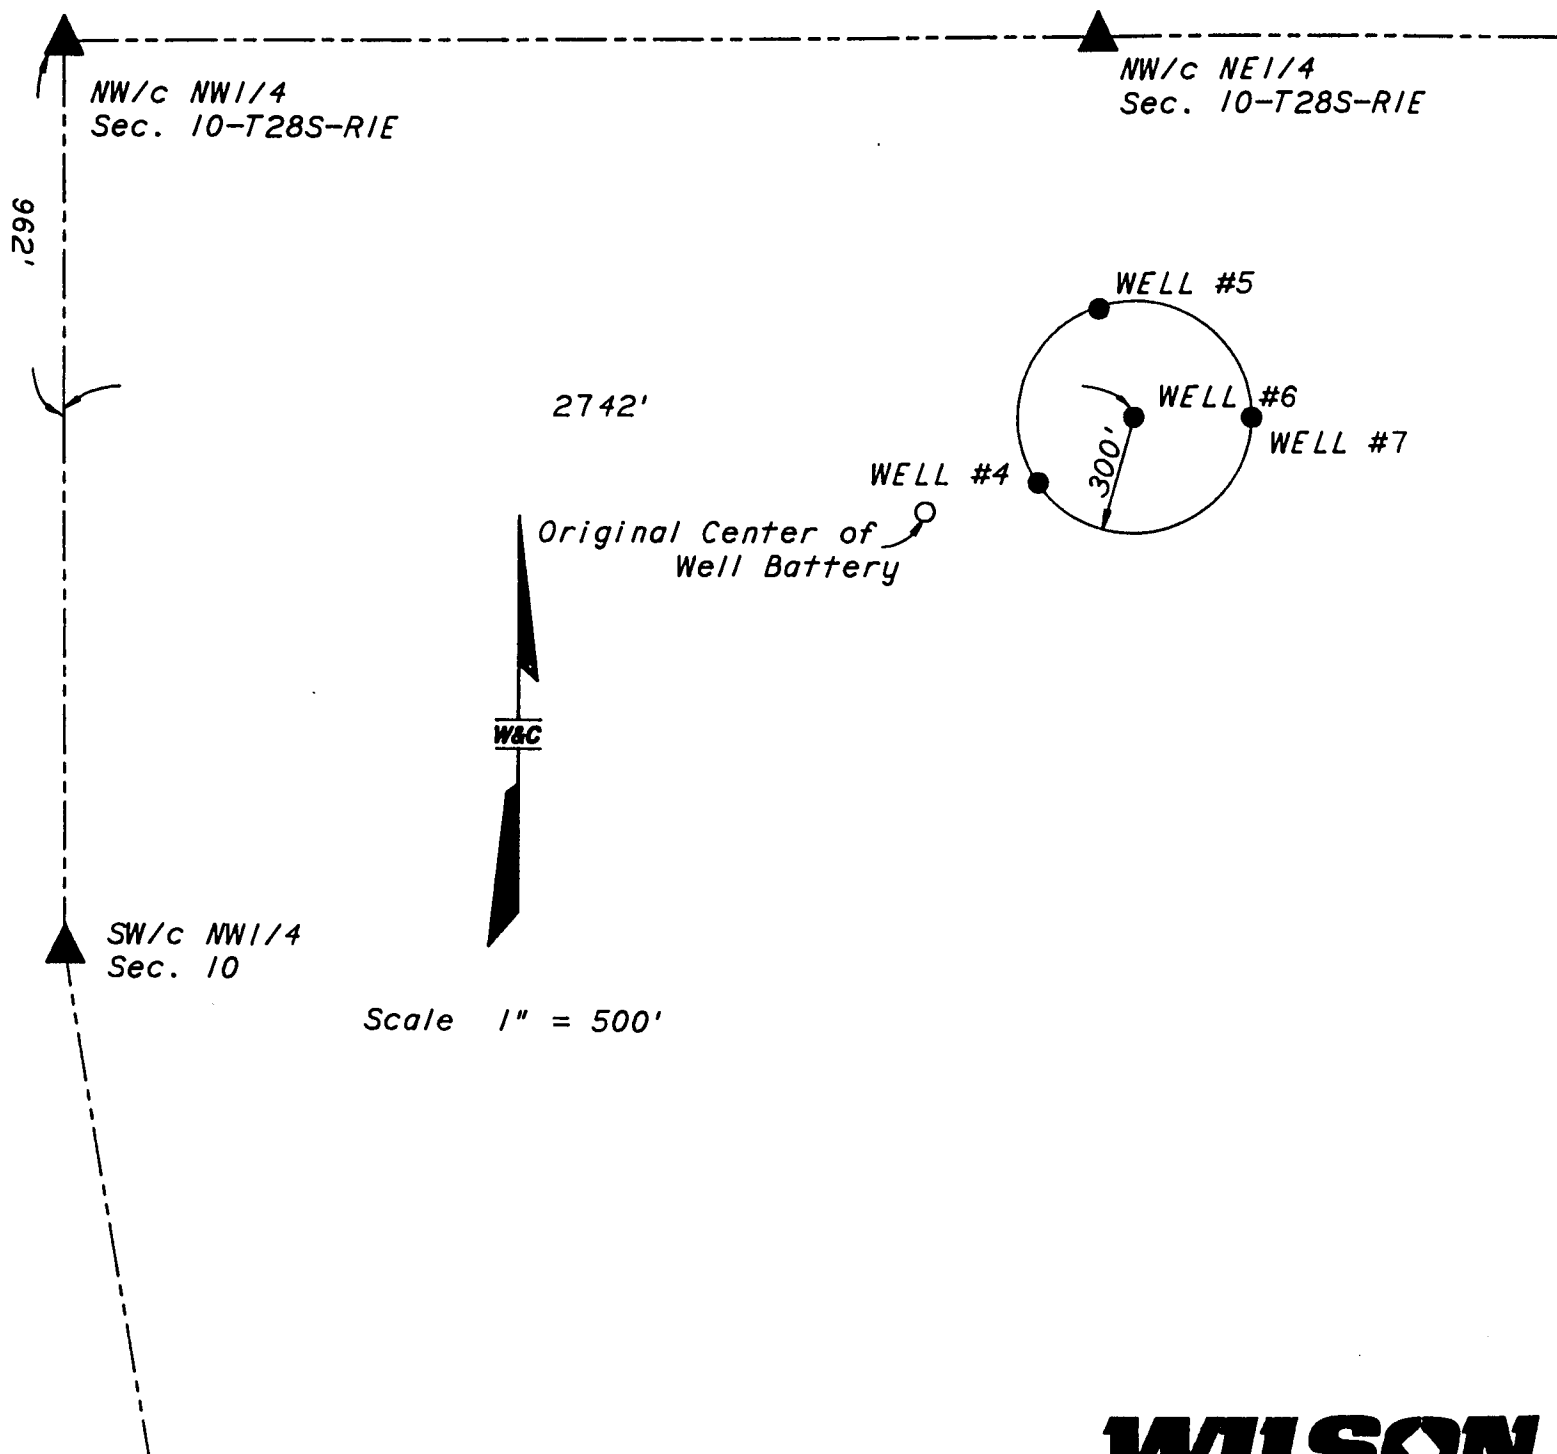

WILSON
& COMPANY