
<u>Well #6-90</u> WE1-L	-3 WATER WELL REG	CORD Form WWC	C-5 KSA 82a-1	212	
1 LOCATION OF WATER WELL:	Fraction	S	Section Number	Township Number	Range Number
County: SEDGWICK Distance and direction from nearest town		1/4 NE 1/4	10	<sub>T</sub> 28 <sub>S</sub>	R 1E E/W
approx. 3100 South Grove		=	•		
WATER WELL OWNER:	City of Wichita				
RR#, St. Address, Box # :	Water & Sewer I			Board of Agriculture,	Division of Water Resources
City, State, ZIP Code			KS.	Application Number:	
LOCATE WELL'S LOCATION WITH 4					
TYPE OF BLANK CASING USED:  1 Steel 3 RMP (SR)  2 PVC 4 ABS  Casing height above land surface	epth(s) Groundwater Encour FELL'S STATIC WATER LEV Pump test data: st. Yield	well water was	ft. 2. below land surfactors of the surfactors o	the ce measured on mo/day/your description hours produced hours pr	3
2 Brass 4 Galvanized		tile 9 A	NBS	12 None used (o	pen hole)
CREEN OR PERFORATION OPENINGS		5 Gauzed wrapped		8 Saw cut	11 None (open hole)
1 Continuous slot 3 Mill s		6 Wire wrapped		9 Drilled holes	
2 Louvered shutter 4 Key   SCREEN-PERFORATED INTERVALS:	punched From 14	7 Torch cut	1	0 Other (specify)	toft.
GRAVEL PACK INTERVALS:  GROUT MATERIAL:  Grout Intervals: From	rent 2 Cement gr to 10 ft., Frontamination:	out 3 Ber	ft., From tonite 4 Of to	ft.  ther	Abandoned water well
2 Sewer lines 5 Cess po		privy wage lagoon	11 Fuel sto	r storage 15 (	Off well/Gas well Other (specify below)
3 Watertight sewer lines 6 Seepage		edyard	13 Insectici	•	lant & Landfill
irection from well?	у р У 1 О	coyara	How many		TOUT . A FORIGITATION
FROM TO	LITHOLOGIC LOG	FROM	TO	PLUGGING	INTERVALS
0 2 Topsoil					
2 7 Tan Cla					
	ne to Fine Sand				
	Coarse Sand and		se Gravei		
21 26 Black S	hale and Limestor	ne			
			1		
CONTRACTOR'S OR LANDOWNER'S	CERTIFICATION: This	er well was (1) cosst	ructed (2) recens	tructed or (2) plugged up	der my jurisdiction and was
ompleted on (mo/day/year)1-8	-91				nowledge and belief. Kansas
Vater Well Contractor's License No					<b>-3</b> 7
	WeII & Pump Serv:		by (signature	7	rnald)
INSTRUCTIONS: Use typewriter or ball point pen.					copies to Kansas Department

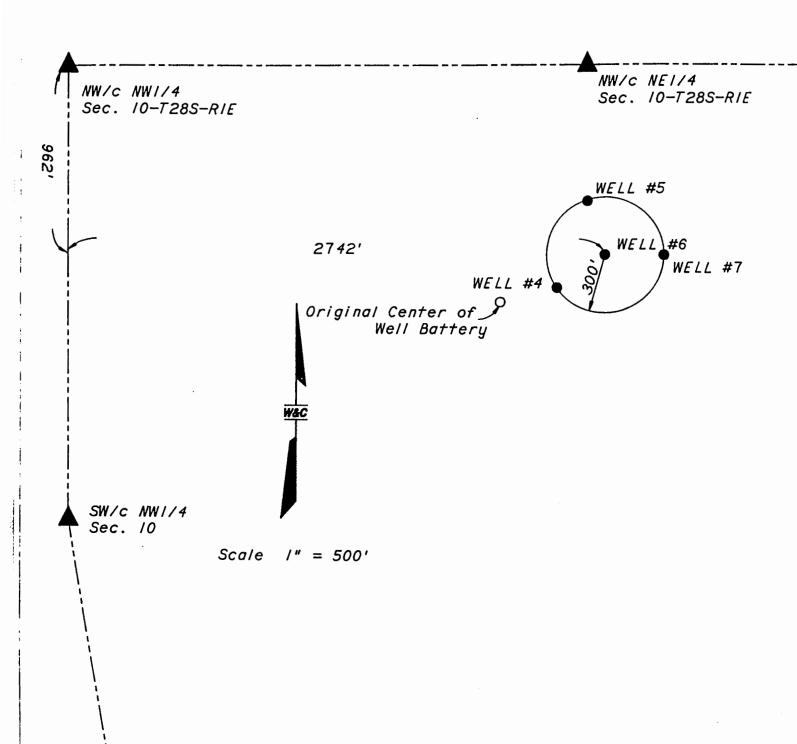

WILSON & COMPANY