


工

E/M

SEC.

1/4

1

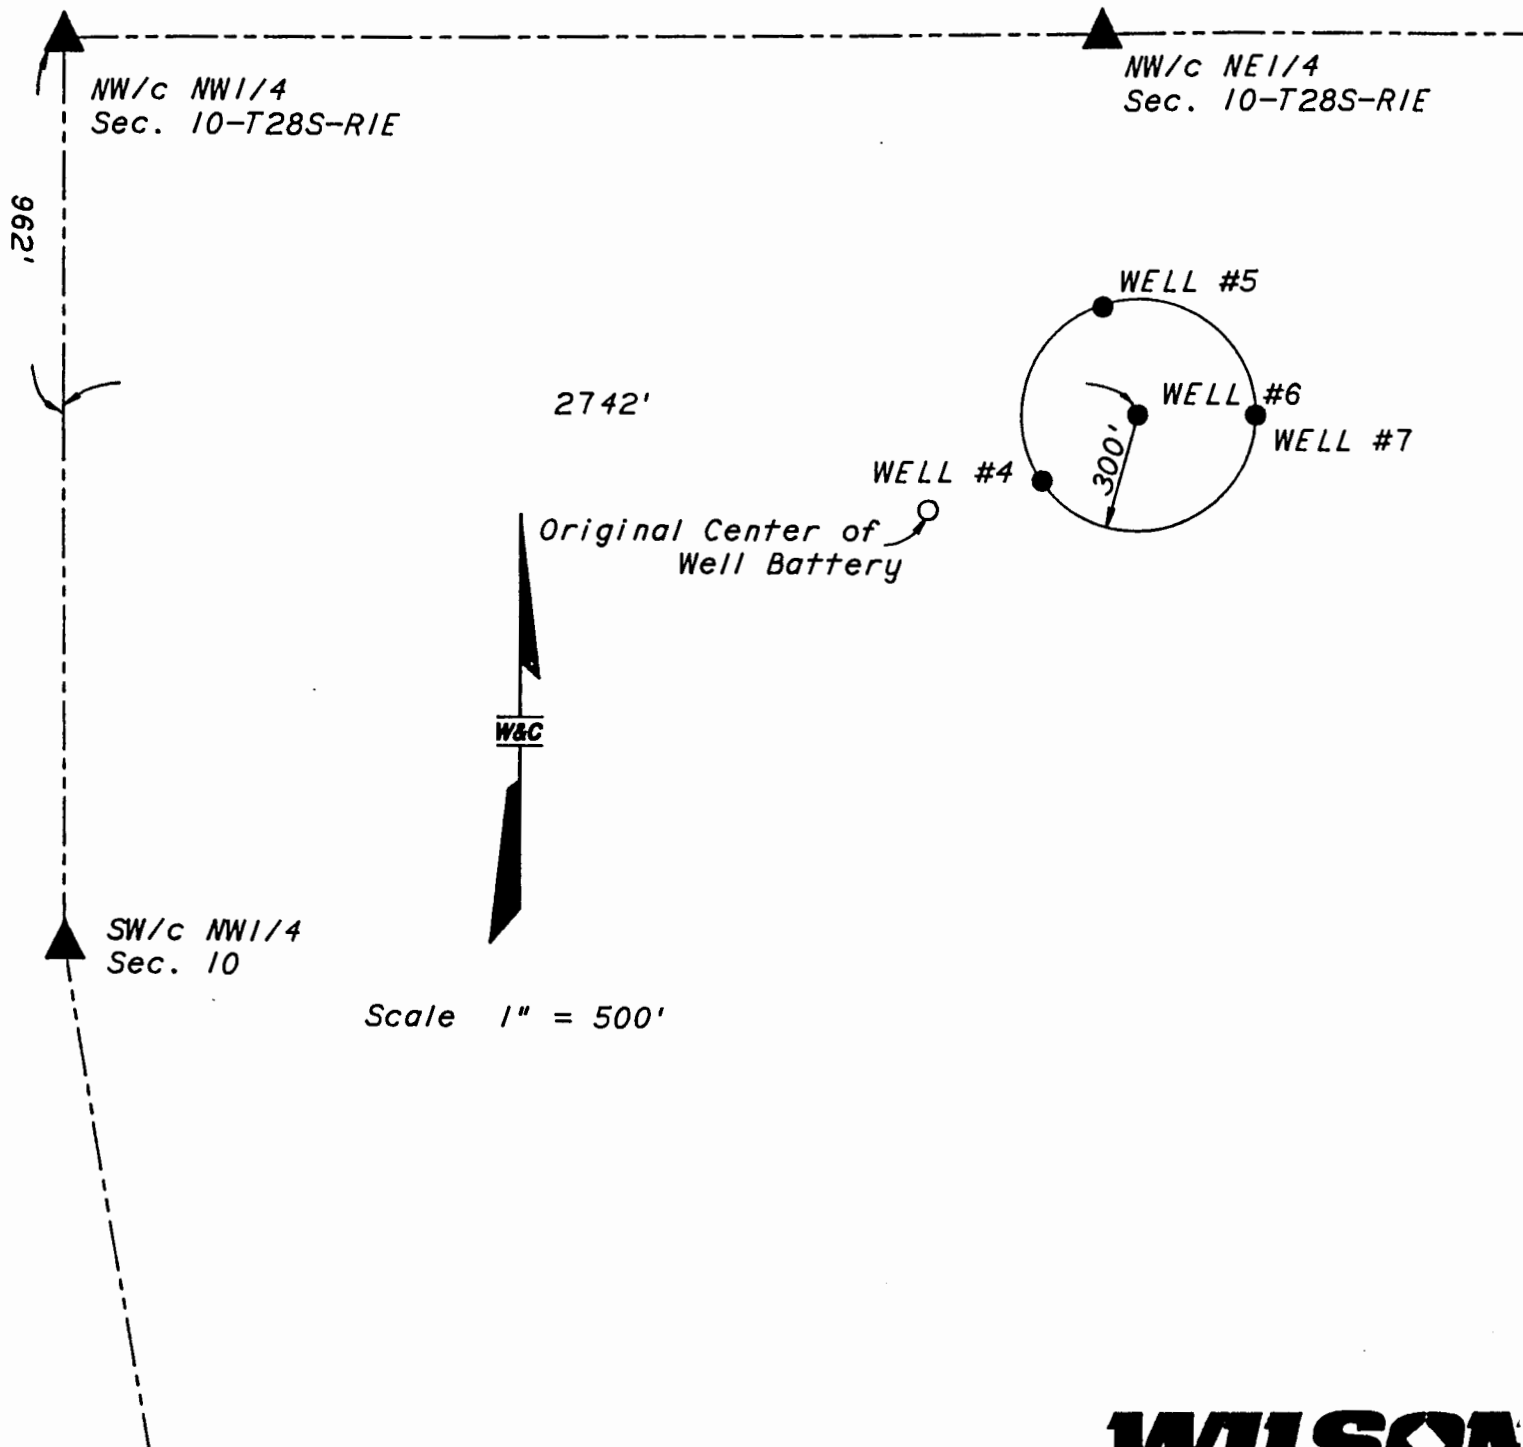

WILSON
& COMPANY