


MW-177

21A092

1 LOCATION OF WATER WELL: Fraction: NE 1/4 SE 1/4 SW 1/4 Section Number: 11 Township Number: T 28 S Range Number: R 1 EW
 County: Sedgwick

Distance and direction from nearest town or city street address of well if located within city?
K-15 & Turnpike; Boeing

2 WATER WELL OWNER: Boeing
 RR#, St. Address, Box #: PO Box 17730 Board of Agriculture, Division of Water Resources
 City, State, ZIP Code: Wichita KS 67277-7730 Application Number:

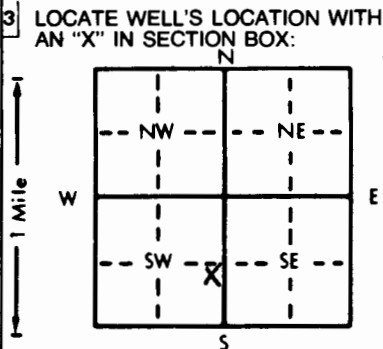

4 DEPTH OF COMPLETED WELL: 34 ft. ELEVATION:
 Depth(s) Groundwater Encountered 1. Dry ft. 2. ft. 3. ft.
 WELL'S STATIC WATER LEVEL 32.4 ft. below land surface measured on mo/day/yr 1-10-94
 Pump test data: Well water was ft. after hours pumping gpm
 Est. Yield gpm: Well water was ft. after hours pumping gpm
 Bore Hole Diameter 8 in. to ft. and in. to ft.
 WELL WATER TO BE USED AS: 5 Public water supply 8 Air conditioning 11 Injection well
 1 Domestic 3 Feedlot 6 Oil field water supply 9 Dewatering 12 Other (Specify below)
 2 Irrigation 4 Industrial 7 Lawn and garden only 10 Monitoring well
 Was a chemical/bacteriological sample submitted to Department? Yes No X; If yes, mo/day/yr sample was submitted Water Well Disinfected? Yes No X

5 TYPE OF BLANK CASING USED: 5 Wrought iron 8 Concrete tile CASING JOINTS: Glued Clamped
 1 Steel 3 RMP (SR) 6 Asbestos-Cement 9 Other (specify below) Welded
2 PVC 4 ABS 7 Fiberglass Threaded Flush
 Blank casing diameter 2 in. to ft. Dia in. to ft. Dia in. to ft.
 Casing height above land surface 36 in., weight 703 lbs./ft. Wall thickness or gauge No. 154

TYPE OF SCREEN OR PERFORATION MATERIAL: 7 PVC 10 Asbestos-cement
 1 Steel 3 Stainless steel 5 Fiberglass 8 RMP (SR) 11 Other (specify)
 2 Brass 4 Galvanized steel 6 Concrete tile 9 ABS 12 None used (open hole)
 SCREEN OR PERFORATION OPENINGS ARE: 5 Gauzed wrapped 8 Saw cut 11 None (open hole)
 1 Continuous slot 3 Mill slot 6 Wire wrapped 9 Drilled holes
 2 Louvered shutter 4 Key punched 7 Torch cut 10 Other (specify)
 SCREEN-PERFORATED INTERVALS: From 20 ft. to 34 ft. From ft. to ft.
 GRAVEL PACK INTERVALS: From 19 ft. to 34 ft. From ft. to ft.

6 GROUT MATERIAL: 1 Neat cement 2 Cement grout 6 Bentonite 4 Other
 Grout Intervals: From 19 ft. to 2 ft. From ft. to ft. From ft. to ft.
 What is the nearest source of possible contamination:
 1 Septic tank 4 Lateral lines 7 Pit privy 10 Livestock pens 14 Abandoned water well
 2 Sewer lines 5 Cess pool 8 Sewage lagoon 11 Fuel storage 15 Oil well/Gas well
 3 Watertight sewer lines 6 Seepage pit 9 Feedyard 12 Fertilizer storage 16 Other (specify below)
 Direction from well? NA How many feet? NA

FROM	TO	LITHOLOGIC LOG	FROM	TO	PLUGGING INTERVALS
0.0	1.0	Topsoil, sandy, silty, clayey			
1.0	7.0	Clay, silty			
7.0	12.0	Clay, slightly sandy			
12.0	22.0	Sand			
22.0	28.5	Sandstone			
28.5	33.0	Clay			
33.0	34.0	Shale			

7 CONTRACTOR'S OR LANDOWNER'S CERTIFICATION: This water well was (1) constructed (2) reconstructed, or (3) plugged under my jurisdiction and was completed on (mo/day/year) 1-10-94 and this record is true to the best of my knowledge and belief. Kansas Water Well Contractor's License No. 531 This Water Well Record was completed on (mo/day/yr) 1-19-94 under the business name of GSI by (signature) Allison Lewis