


1 LOCATION OF WATER WELL: County: Sedgwick	Fraction SE 1/4 SW 1/4 NE 1/4	Section Number 11	Township Number T 28 S	Range Number R 1 E
---	----------------------------------	----------------------	---------------------------	-----------------------

Distance and direction from nearest town or city street address of well if located within city?	Plant #	
2,800 Feet SW From the Intersection of 31st Street South and Oliver, Wichita, KS	52905009	MW-79

2 WATER WELL OWNER: Boeing Military Airplanes		Board of Agriculture, Division of Water Resources Application Number:
RR#, St. Address, Box # :	P.O. Box 7730, M/S K11-65	
City, State, ZIP Code :	Wichita, KS 67277-7730	

3	LOCATE WELL'S LOCATION WITH AN "X" IN SECTION BOX:	4	DEPTH OF COMPLETED WELL..... 55.0	ft. ELEVATION: Approximate Surface Elevation: 1338.9
---	--	---	-----------------------------------	--

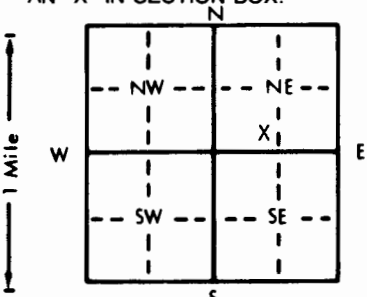

4 DEPTH OF COMPLETED WELL..... 55.0 ft. ELEVATION: Approximate Surface Elevation: 1338.9
Depth(s) Groundwater Encountered 1..... 14 ft. 2..... ft. 3..... ft.
WELL'S STATIC WATER LEVEL 3.6 ft. below land surface measured on mo/day/yr 06/28/90
Pump test data: Well water was ft. after hours pumping gpm
Est. Yield N/A gpm: Well water was ft. after hours pumping gpm
Bore Hole Diameter..... 33 in. to 55.0 ft., and in. to ft.
WELL WATER TO BE USED AS: 5 Public water supply 8 Air conditioning 11 Injection well
1 Domestic 3 Feedlot 6 Oil field water supply 9 Dewatering 12 Other (Specify below)
2 Irrigation 4 Industrial 7 Lawn and garden only 10 Monitoring well
Was a chemical/bacteriological sample submitted to Department? Yes..... No..... X..... If yes, mo/day/yr sample was sub-
mitted..... Water Well Disinfected? Yes..... No..... X.....

5 TYPE OF BLANK CASING USED:		5 Wrought iron	8 Concrete tile	CASING JOINTS: Glued Clamped	
1 Steel	3 RMP (SR)	6 Asbestos-Cement	9 Other (specify below)	Welded	
2 PVC	4 ABS	7 Fiberglass		Threaded X	
Blank casing diameter 4 . . . in. to . . . 8.0 . . . ft., Dia		. . . in. to ft., Dia		. . . in. to ft.	
Casing height above land surface 45.1 . . . in., weight		lbs./ft. Wall thickness or gauge No. Schedule 40			

TYPE OF SCREEN OR PERFORATION MATERIAL:

1 Steel	3 Stainless steel	5 Fiberglass	7 PVC	10 Asbestos-cement
2 Brass	4 Galvanized steel	6 Concrete tile	8 RMP (SR)	11 Other (specify)
			9 ABS	12 None used (open hole)

SCREEN OR PERFORATION OPENINGS ARE:

1 Continuous slot	<u>3</u> Mill slot	5 Gauzed wrapped	8 Saw cut	11 None (open hole)
2 Louvered shutter	4 Key punched	6 Wire wrapped	9 Drilled holes	
		7 Torch cut	10 Other (specify)	

SCREEN-PERFORATED INTERVALS:	From	8.0	ft. to	54.5	ft., From	ft. to	ft.
	From		ft. to		ft., From	ft. to	ft.
GRAVEL PACK INTERVALS:	From	7.0	ft. to	55.0	ft., From	ft. to	ft.
	From		ft. to		ft., From	ft. to	ft.

6. GROUT MATERIAL: ☒ 1 Neat cement 2 Cement grout ☒ 3 Bentonite 4 Other
Grout Intervals: From 0 ft. to 5.5 ft. From 5.5 ft. to 7.0 ft. From ft. to ft.

What is the nearest source of possible contamination:

1 Septic tank	4 Lateral lines	7 Pit privy	10 Livestock pens	14 Abandoned water well
2 Sewer lines	5 Cess pool	8 Sewage lagoon	11 Fuel storage	15 Oil well/Gas well
3 Watertight sewer lines	6 Seepage pit	9 Feedyard	12 Fertilizer storage	16 Other (specify below)
			13 Insecticide storage	 Industrial Warehouse

Direction from well? East How many feet? 75

[illegible]

7 CONTRACTOR'S OR LANDOWNER'S CERTIFICATION: This water well was (1) constructed, (2) reconstructed, or (3) plugged under my jurisdiction and was completed on (mo/day/year) 10/03/91 and this record is true to the best of my knowledge and belief. Kansas Water Well Contractor's License No. 416 This Water Well Record was completed on (mo/day/yr) 11/15/91 under the business name of Terracon Consultants, Inc. by (signature) Steve Fischer