


1 LOCATION OF WATER WELL:	Fraction	Section Number	Township Number	Range Number
County: Sedgwick	SW ¼ SW ¼ NW ¼	11	T 28 S	R 1 E/W

Distance and direction from nearest town or city street address of well if located within city?	K-15 Springs
1000' NW of K-15 and I-35 (K.T.A.), Wichita, KS	52905062 MW-82

2	WATER WELL OWNER:	Boeing Military Airplanes	
	RR#, St. Address, Box # :	P.O. Box 7730, M/S K11-65	Board of Agriculture, Division of Water Resources
	City, State, ZIP Code :	Wichita, KS 67277-7730	Application Number:

3	LOCATE WELL'S LOCATION WITH AN "X" IN SECTION BOX:	4	DEPTH OF COMPLETED WELL..... 22.5 ft. ELEVATION: Approx. Surface Elev.: 1299.4	
			Depth(s) Groundwater Encountered 1. 8.5 ft 2. ft 3. ft	

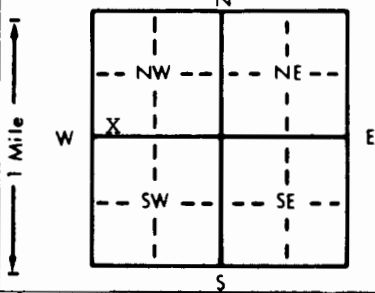

4 DEPTH OF COMPLETED WELL... 22.5 ft. ELEVATION: Approx. Surface Elev.: 1299.4
Depth(s) Groundwater Encountered 1. 8.5 ft. 2. ft. 3. ft.
WELL'S STATIC WATER LEVEL ... 8.6 ft. below land surface measured on mo/day/yr 11/16/90
Pump test data: Well water was ft. after hours pumping gpm
Est. Yield ... N/A gpm: Well water was ft. after hours pumping gpm
Bore Hole Diameter9 in. to 22.5 ft., and in. to ft.
WELL WATER TO BE USED AS: 5 Public water supply 8 Air conditioning 11 Injection well
1 Domestic 3 Feedlot 6 Oil field water supply 9 Dewatering 12 Other (Specify below)
2 Irrigation 4 Industrial 7 Lawn and garden only 10 Monitoring well
Was a chemical/bacteriological sample submitted to Department? Yes.....No.....X....; If yes, mo/day/yr sample was submitted
Water Well Disinfected? Yes No X

5	TYPE OF BLANK CASING USED:		5 Wrought iron	8 Concrete tile	CASING JOINTS: Glued Clamped Welded Threaded X
	1 Steel	3 RMP (SR)	6 Asbestos-Cement	9 Other (specify below)	
	2 PVC	4 ABS	7 Fiberglass		

Blank casing diameter 2 in. to 4.5 ft., Dia in. to ft., Dia in. to ft.
Casing height above land surface 38.3 in., weight lbs./ft. Wall thickness or gauge No. **Schedule 40**

TYPE OF SCREEN OR PERFORATION MATERIAL:

1 Steel	3 Stainless steel	5 Fiberglass	7 PVC	10 Asbestos-cement
2 Brass	4 Galvanized steel	6 Concrete tile	8 RMP (SR)	11 Other (specify)
			9 ABS	12 None used (open hole)

[illegible]

SCREEN-PERFORATED INTERVALS:	From 4.5 ft. to 22.0 ft.,	From ft. to ft.
	From ft. to ft.,	From ft. to ft.
GRAVEL PACK INTERVALS:	From 4.0 ft. to 22.5 ft.,	From ft. to ft.
	From ft. to ft.,	From ft. to ft.

6. GROUT MATERIAL: 1 Neat cement 2 Cement grout 3 Bentonite 4 Other
Grout Intervals: From 0 ft. to 2.0 ft. From 2.0 ft. to 4.0 ft. From ft. to ft.

What is the nearest source of possible contamination:

1 Septic tank	4 Lateral lines	7 Pit privy	10 Livestock pens	14 Abandoned water well
2 Sewer lines	5 Cess pool	8 Sewage lagoon	11 Fuel storage	15 Oil well/Gas well
3 Watertight sewer lines	6 Seepage pit	9 Feedyard	12 Fertilizer storage	16 Other (specify below)
			13 Insecticide storage	... Industrial Facility.

Direction from well? East Southeast

How many feet? 2,300

[illegible]

7 CONTRACTOR'S OR LANDOWNER'S CERTIFICATION: This water well was (1) constructed, (2) reconstructed, or (3) plugged under my jurisdiction and was completed on (mo/day/year) 10/10/90 and this record is true to the best of my knowledge and belief. Kansas Water Well Contractor's License No. 416 This Water Well Record was completed on (mo/day/yr) 2/14/91 under the business name of Terracon Consultants, Inc. by (signature) [Signature]