


1 LOCATION OF WATER WELL: County: Sedgwick Fraction: SE 1/4 NW 1/4 SW 1/4 Section Number: 11 Township Number: T 28 S Range Number: R 1 E/W
 Distance and direction from nearest town or city street address of well if located within city? 300' SW of K-15 and I-35 (K.T.A.), Wichita, KS K-15 Springs 52905062 MW-84

2 WATER WELL OWNER: Boeing Military Airplanes Board of Agriculture, Division of Water Resources
 RR#, St. Address, Box #: P.O. Box 7730, M/S K11-65 Application Number:
 City, State, ZIP Code: Wichita, KS 67277-7730 Approx. Surface Elev.: 1308.9

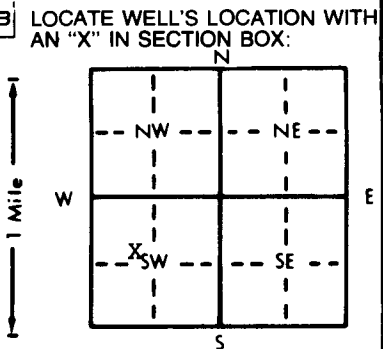

4 DEPTH OF COMPLETED WELL: 28.5 ft. ELEVATION: 1308.9
 Depth(s) Groundwater Encountered: 1. 10 ft. 2. _____ ft. 3. _____ ft.
 WELL'S STATIC WATER LEVEL: 21.0 ft. below land surface measured on mo/day/yr 11/16/90
 Pump test data: Well water was _____ ft. after _____ hours pumping _____ gpm
 Est. Yield: N/A gpm: Well water was _____ ft. after _____ hours pumping _____ gpm
 Bore Hole Diameter: 9 in. to 28.5 ft., and _____ in. to _____ ft.
 WELL WATER TO BE USED AS:
 1 Domestic 3 Feedlot 6 Oil field water supply 9 Dewatering 11 Injection well
 2 Irrigation 4 Industrial 7 Lawn and garden only 10 Monitoring well 12 Other (Specify below)
 Was a chemical/bacteriological sample submitted to Department? Yes _____ No X; If yes, mo/day/yr sample was submitted _____
 Water Well Disinfected? Yes _____ No X

5 TYPE OF BLANK CASING USED:
 1 Steel 3 RMP (SR) 5 Wrought iron 8 Concrete tile CASING JOINTS: Glued _____ Clamped _____
2 PVC 4 ABS 6 Asbestos-Cement 9 Other (specify below) Welded _____
 7 Fiberglass _____ Threaded _____ X _____
 Blank casing diameter: 2 in. to 7.0 ft., Dia. _____ in. to _____ ft., Dia. _____ in. to _____ ft.
 Casing height above land surface: 34.4 in., weight _____ lbs./ft. Wall thickness or gauge No. Schedule 40
 TYPE OF SCREEN OR PERFORATION MATERIAL:
 1 Steel 3 Stainless steel 5 Fiberglass 7 PVC 10 Asbestos-cement
 2 Brass 4 Galvanized steel 6 Concrete tile 8 RMP (SR) 11 Other (specify) _____
 9 ABS 12 None used (open hole)
 SCREEN OR PERFORATION OPENINGS ARE:
 1 Continuous slot 3 Mill slot 5 Gauzed wrapped 8 Saw cut 11 None (open hole)
 2 Louvered shutter 4 Key punched 6 Wire wrapped 9 Drilled holes
 7 Torch cut 10 Other (specify) _____
 SCREEN-PERFORATED INTERVALS: From 7.0 ft. to 27.0 ft., From _____ ft. to _____ ft.
 From _____ ft. to _____ ft., From _____ ft. to _____ ft.
 GRAVEL PACK INTERVALS: From 6.0 ft. to 28.5 ft., From _____ ft. to _____ ft.
 From _____ ft. to _____ ft., From _____ ft. to _____ ft.

6 GROUT MATERIAL: 1 Neat cement 2 Cement grout 3 Bentonite 4 Other _____
 Grout Intervals: From 0 ft. to 4.0 ft., From 4.0 ft. to 6.0 ft., From _____ ft. to _____ ft.
 What is the nearest source of possible contamination:
 1 Septic tank 4 Lateral lines 7 Pit privy 11 Fuel storage 14 Abandoned water well
 2 Sewer lines 5 Cess pool 8 Sewage lagoon 12 Fertilizer storage 15 Oil well/Gas well
 3 Watertight sewer lines 6 Seepage pit 9 Feedyard 13 Insecticide storage 16 Other (specify below)
 Direction from well? Southeast How many feet? 1,300

FROM	TO	LITHOLOGIC LOG	FROM	TO	PLUGGING INTERVALS
0	6.0	Fill: Silty Lean Clay, Dark Brown			
6.0	13.5	Clayey Silt with Sand, Light Brown			
13.5	20.5	Medium to Coarse Sand, Light Brown			
20.5	22.0	Sandstone			
22.0	26.5	Highly Weathered Shale, Olive-Gray			
26.5	28.5	Shale, Dark Gray			

7 CONTRACTOR'S OR LANDOWNER'S CERTIFICATION: This water well was 1 constructed, (2) reconstructed, or (3) plugged under my jurisdiction and was completed on (mo/day/year) 09/25/90 and this record is true to the best of my knowledge and belief. Kansas Water Well Contractor's License No. 416. This Water Well Record was completed on (mo/day/yr) 2/14/91 under the business name of Terracon Consultants, Inc. by (signature) [Signature]

OFFICE USE ONLY
T
R
EW
SEC.
1/4
1/4
1/4