


1 LOCATION OF WATER WELL: County: Sedgwick Fraction NW 1/4 NE 1/4 NE 1/4 Section Number 11 Township Number T 28 S Range Number R 1 **EW**

Distance and direction from nearest town or city street address of well if located within city? 200' SW of 3216 Turnpike Drive; Wichita, KS Job No. 50885144 MW-1

2 WATER WELL OWNER: Boeing Military Airplanes RR#, St. Address, Box # : P.O. Box 7730, MS K06-00 Board of Agriculture, Division of Water Resources City, State, ZIP Code : Wichita, KS 67277-7730 Application Number:

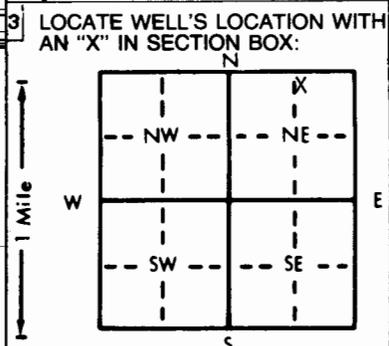

4 DEPTH OF COMPLETED WELL: 38.5 ft. ELEVATION: Approx. Surface Elev: 1346.9  
 Depth(s) Groundwater Encountered 1. 27 ft. 2. ft. 3. ft.  
 WELL'S STATIC WATER LEVEL 9.1 ft. below land surface measured on mo/day/yr 11/08/88  
 Pump test data: Well water was ft. after hours pumping gpm  
 Est. Yield N/A gpm: Well water was ft. after hours pumping gpm  
 Bore Hole Diameter 10 in. to 39 ft., and in. to ft.  
 WELL WATER TO BE USED AS: 5 Public water supply 8 Air conditioning 11 Injection well  
 1 Domestic 3 Feedlot 6 Oil field water supply 9 Dewatering 12 Other (Specify below)  
 2 Irrigation 4 Industrial 7 Lawn and garden only **10** Monitoring well  
 Was a chemical/bacteriological sample submitted to Department? Yes No **X**; If yes, mo/day/yr sample was submitted Water Well Disinfected? Yes No **X**

5 TYPE OF BLANK CASING USED: 1 Steel 2 **PVC** 3 RMP (SR) 4 ABS 5 Wrought iron 6 Asbestos-Cement 7 Fiberglass 8 Concrete tile 9 Other (specify below) CASING JOINTS: Glued Clamped Welded Threaded **X**  
 Blank casing diameter 2 in. to 18 ft., Dia in. to ft., Dia in. to ft.  
 Casing height above land surface 24 in., weight lbs./ft. Wall thickness or gauge No. Schedule 40  
 TYPE OF SCREEN OR PERFORATION MATERIAL: 1 Steel 2 Brass 3 Stainless steel 4 Galvanized steel 5 Fiberglass 6 Concrete tile 7 **PVC** 8 RMP (SR) 9 ABS 10 Asbestos-cement 11 Other (specify) 12 None used (open hole)  
 SCREEN OR PERFORATION OPENINGS ARE: 1 Continuous slot 2 Louvered shutter 3 **Mill slot** 4 Key punched 5 Gauzed wrapped 6 Wire wrapped 7 Torch cut 8 Saw cut 9 Drilled holes 10 Other (specify) 11 None (open hole)  
 SCREEN-PERFORATED INTERVALS: From 18 ft. to 38.5 ft., From ft. to ft., From ft. to ft.  
 GRAVEL PACK INTERVALS: From 17 ft. to 38.5 ft., From ft. to ft., From ft. to ft.

6 GROUT MATERIAL: 1 Neat cement 2 Cement grout 3 **Bentonite** 4 Other  
 Grout intervals: From 16 ft. to 17 ft., From ft. to ft., From ft. to ft.  
 What is the nearest source of possible contamination: 1 Septic tank 2 Sewer lines 3 Watertight sewer lines 4 Lateral lines 5 Cess pool 6 Seepage pit 7 Pit privy 8 Sewage lagoon 9 Feedyard 10 Livestock pens 11 Fuel storage 12 Fertilizer storage 13 Insecticide storage 14 Abandoned water well 15 Oil well/Gas well **16** Other (specify below) Industrial Plant  
 Direction from well? East How many feet? 800

FROM	TO	LITHOLOGIC LOG	FROM	TO	PLUGGING INTERVALS
0	5	Brown Lean to Fat Clay			
5	6.5	Red Fat Clay			
6.5	35.0	Olive-Green Highly Weathered Shale			
35.0	39.0	Gray Shale			
Casing was removed and boring was plugged with bentonite - cement grout to 25' on 12/01/88.					

7 CONTRACTOR'S OR LANDOWNER'S CERTIFICATION: This water well was **1** constructed, **2** reconstructed, or **3** plugged under my jurisdiction and was completed on (mo/day/year) (1) 11/03/88 (3) 12/01/88 and this record is true to the best of my knowledge and belief. Kansas Water Well Contractor's License No. **AL6** This Water Well Record was completed on (mo/day/yr) **12-12-88** under the business name of **Terracon Consultants, INC** by (signature) *[Signature]*