

1 LOCATION OF WATER WELL: Fraction SW Section Number 11 Township Number T 28 S Range Number R 1 EW
 County: Sedgwick NW 1/4 NE 1/4 SE 1/4

Distance and direction from nearest town or city street address of well if located within city?

3801 S Oliver

KTA + K-15

MW 49

2 WATER WELL OWNER: Boeing Military Airplane Co.

RR#, St. Address, Box #: 7730 P.O. BOX


Board of Agriculture, Division of Water Resources

City, State, ZIP Code: Wichita, KS 67277

Application Number:

3 LOCATE WELL'S LOCATION WITH AN "X" IN SECTION BOX:

4 DEPTH OF COMPLETED WELL: 30 ft. ELEVATION: 1310.9

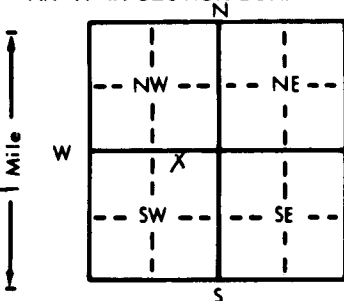

Depth(s) Groundwater Encountered 1. ft. 2. ft. 3. ft.

WELL'S STATIC WATER LEVEL ft. below land surface measured on mo/day/yr

Pump test data: Well water was ft. after hours pumping gpm

Est. Yield gpm: Well water was ft. after hours pumping gpm

Bore Hole Diameter: 8 in. to 30 ft., and in. to ft.

WELL WATER TO BE USED AS: 5 Public water supply 8 Air conditioning 11 Injection well

1 Domestic 3 Feedlot 6 Oil field water supply 9 Dewatering 12 Other (Specify below)

2 Irrigation 4 Industrial 7 Lawn and garden only 10 Observation well

Was a chemical/bacteriological sample submitted to Department? Yes No X If yes, mo/day/yr sample was submitted

Water Well Disinfected? Yes No X

5 TYPE OF BLANK CASING USED:

5 Wrought iron

8 Concrete tile

CASING JOINTS: Glued Clamped X

1 Steel

3 RMP (SR)

6 Asbestos-Cement

9 Other (specify below)

Welded

2 PVC

4 ABS

7 Fiberglass

Threaded

Blank casing diameter 4 in. to 12 ft., Dia in. to ft., Dia in. to ft.

Casing height above land surface 6 in., weight 2.001 lbs./ft. Wall thickness or gauge No. Sch 40

TYPE OF SCREEN OR PERFORATION MATERIAL:

1 Steel

3 Stainless steel

5 Fiberglass

7 PVC

10 Asbestos-cement

2 Brass

4 Galvanized steel

6 Concrete tile

8 RMP (SR)

11 Other (specify)

SCREEN OR PERFORATION OPENINGS ARE:

1 Continuous slot

3 Mill slot

5 Gauzed wrapped

8 Saw cut

11 None (open hole)

2 Louvered shutter

4 Key punched

6 Wire wrapped

9 Drilled holes

7 Torch cut

10 Other (specify)

SCREEN-PERFORATED INTERVALS: From 12 ft. to 27 ft., From ft. to ft.

From ft. to ft., From ft. to ft.

GRAVEL PACK INTERVALS: From 11 ft. to 27 ft., From ft. to ft.

From ft. to ft., From ft. to ft.

6 GROUT MATERIAL:

1 Neat cement

2 Cement grout

3 Bentonite

4 Other

Grout Intervals: From 0 ft. to 11 ft., From ft. to ft., From ft. to ft.

What is the nearest source of possible contamination:

1 Septic tank

4 Lateral lines

7 Pit privy

10 Livestock pens

14 Abandoned water well

2 Sewer lines

5 Cess pool

8 Sewage lagoon

11 Fuel storage

15 Oil well/Gas well

3 Watertight sewer lines

6 Seepage pit

9 Feedyard

12 Fertilizer storage

16 Other (specify below)

13 Insecticide storage

WWTP

Direction from well?

E

How many feet? 500

FROM	TO	LITHOLOGIC LOG	FROM	TO	LITHOLOGIC LOG
		grouted from 27 feet			
		to 3 feet w neat cement			
		grout, Top 3 feet back			
		filled with silty clay,			
		after 3' of			
		All casing pulled before			
		grouting			

7 CONTRACTOR'S OR LANDOWNER'S CERTIFICATION: This water well was (1) constructed, (2) reconstructed, or (3) plugged under my jurisdiction and was completed on (mo/day/year) 9.11.87 and this record is true to the best of my knowledge and belief. Kansas

Water Well Contractor's License No. 415 This Water Well Record was completed on (mo/day/yr) 9.11.87

under the business name of Daniels Drilling Co by (signature) Albert Stout

INSTRUCTIONS: Use typewriter or ball point pen. PLEASE PRESS FIRMLY and PRINT clearly. Please fill in blanks, underline or circle the correct answers. Send top three copies to Kansas Department of Health and Environment, Bureau of Water Protection, Topeka, Kansas 66620-7320, Telephone: 913-862-9360. Send one to WATER WELL OWNER and retain one for your records.