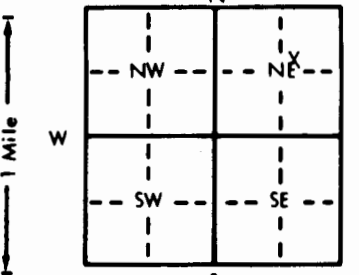


1 LOCATION OF WATER WELL:		Fraction		Section Number	Township Number	Range Number
County: Sedgwick		NE 1/4 NE 1/4 SW 1/4		11	T 28 S	R 1 EW
Distance and direction from nearest town or city street address of well if located within city? 150 Feet East and 900 Feet North of K-15 Turnpike Toll Booth, Wichita, Kansas 01918008 MW-103						
2 WATER WELL OWNER: Boeing Commercial Airplane Group RR#, St. Address, Box #: P.O. Box 7730, Mail Stop K11-65 Board of Agriculture, Division of Water Resources City, State, ZIP Code: Wichita, KS 67277-7730 Application Number:						
3 LOCATE WELL'S LOCATION WITH AN "X" IN SECTION BOX:		4 DEPTH OF COMPLETED WELL: 31.5 ft. ELEVATION: 1311.9				
		Depth(s) Groundwater Encountered 1. 12.5 ft. 2. ft. 3. ft. WELL'S STATIC WATER LEVEL 13.1 ft. below land surface measured on mo/day/yr 11/22/91 Pump test data: Well water was ft. after hours pumping gpm Est. Yield N/A gpm: Well water was ft. after hours pumping gpm Bore Hole Diameter 8.3 in. to 31.5 ft. and in. to ft. WELL WATER TO BE USED AS: 5 Public water supply 8 Air conditioning 11 Injection well 1 Domestic 3 Feedlot 6 Oil field water supply 9 Dewatering 12 Other (Specify below) 2 Irrigation 4 Industrial 7 Lawn and garden only 10 Monitoring well Was a chemical/bacteriological sample submitted to Department? Yes No X; If yes, mo/day/yr sample was submitted Water Well Disinfected? Yes No X				
5 TYPE OF BLANK CASING USED: 1 Steel 3 RMP (SR) 5 Wrought iron 8 Concrete tile CASING JOINTS: Glued Clamped 2 PVC 4 ABS 6 Asbestos-Cement 9 Other (specify below) Welded Blank casing diameter 2.0 in. to 11.0 ft. Dia in. to ft. Dia in. to ft. Casing height above land surface 35 in. weight lbs./ft. Wall thickness or gauge No. SCH. 40 TYPE OF SCREEN OR PERFORATION MATERIAL: 1 Steel 3 Stainless steel 5 Fiberglass 8 RMP (SR) 10 Asbestos-cement 2 Brass 4 Galvanized steel 6 Concrete tile 9 ABS 11 Other (specify) 12 None used (open hole) SCREEN OR PERFORATION OPENINGS ARE: 1 Continuous slot 3 Mill slot 5 Gauzed wrapped 8 Saw cut 11 None (open hole) 2 Louvered shutter 4 Key punched 6 Wire wrapped 9 Drilled holes 10 Other (specify) SCREEN-PERFORATED INTERVALS: From 11.0 ft. to 31.5 ft. From ft. to ft. GRAVEL PACK INTERVALS: From 10.0 ft. to 31.5 ft. From ft. to ft.						
6 GROUT MATERIAL: 1 Neat cement 2 Cement grout 3 Bentonite 4 Other Grout Intervals: From 0.0 ft. to 8.0 ft. From 8.0 ft. to 10.0 ft. From ft. to ft. What is the nearest source of possible contamination: 1 Septic tank 4 Lateral lines 7 Pit privy 10 Livestock pens 14 Abandoned water well 2 Sewer lines 5 Cess pool 8 Sewage lagoon 11 Fuel storage 15 Oil well/Gas well 3 Watertight sewer lines 6 Seepage pit 9 Feedyard 12 Fertilizer storage 16 Other (specify below) 13 Insecticide storage Direction from well? East How many feet? Approx. 200'						
FROM		TO		LITHOLOGIC LOG		FROM TO PLUGGING INTERVALS
0		3.5		Brown to Dark Brown Fat Clay		
3.5		5.5		Brown Lean to Fat Clay		
5.5		9.0		Light Brown Clayey Sand		
9.0		15.0		Light Brown Fine to Coarse Sand		
15.0		17.0		Light Brown Sandstone		
17.0		20.5		Fine to Coarse Sand with Sandstone Seams		
20.5		29.5		Olive-Brown to Olive-Gray Highly Weathered Shale		
29.5		31.5		Dark Gray Weathered Shale		
7 CONTRACTOR'S OR LANDOWNER'S CERTIFICATION: This water well was 1 constructed, (2) reconstructed, or (3) plugged under my jurisdiction and was completed on (mo/day/year) 11/04/91 and this record is true to the best of my knowledge and belief. Kansas Water Well Contractor's License No. 416 This Water Well Record was completed on (mo/day/yr) 11-6-94 under the business name of Terracon Consultants SC, Inc. by (signature) Steve Fischer						
INSTRUCTIONS: Use typewriter or ball point pen. PLEASE PRESS FIRMLY and PRINT clearly. Please fill in blanks, underline or circle the correct answers. Send top three copies to Kansas Department of Health and Environment, Bureau of Water, Topeka, Kansas 66620-0001. Telephone: 913-296-5545. Send one to WATER WELL OWNER and retain one for your records.						