

RW-136 2011065

WATER WELL RECORD Form WWC-5 KSA 82a-1212


1 LOCATION OF WATER WELL: County: SEDGWICK	Fraction: SE 1/4 SE NW SE NE 1/4 NW 1/4	Section Number: 11	Township Number: T 28 S	Range Number: R 1 E/W
--	--	---------------------------	--------------------------------	------------------------------

Distance and direction from nearest town or city street address of well if located within city?

PLANT 2 - BOEING

2 WATER WELL OWNER: **BOEING**
 RR#, St. Address, Box #: **P.O. Box 7130**
 City, State, ZIP Code: **WICHITA, KS 67277-7130**
 Board of Agriculture, Division of Water Resources
 Application Number:

3 LOCATE WELL'S LOCATION WITH AN "X" IN SECTION BOX:

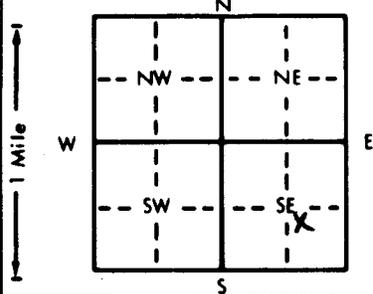

4 DEPTH OF COMPLETED WELL: **61.0** ft. ELEVATION: **NA**
 Depth(s) Groundwater Encountered: **30** ft.
 WELL'S STATIC WATER LEVEL: **29.08** ft. below land surface measured on (mo/day/yr) **3-7-93**
 Pump test data: Well water was _____ ft. after _____ hours pumping _____ gpm
 Est. Yield _____ gpm: Well water was _____ ft. after _____ hours pumping _____ gpm
 Bore Hole Diameter: **8.25** in. to _____ ft., and _____ in. to _____ ft.
 WELL WATER TO BE USED AS:
 1 Domestic 3 Feedlot 6 Oil field water supply 9 Dewatering 12 Other (Specify below)
 2 Irrigation 4 Industrial 7 Lawn and garden only **Monitoring well**
 Was a chemical/bacteriological sample submitted to Department? Yes _____ No **X** _____; If yes, mo/day/yr sample was submitted _____
 Water Well Disinfected? Yes _____ No **(No)**

5 TYPE OF BLANK CASING USED:
 1 Steel 3 RMP (SR) 5 Wrought iron 8 Concrete tile CASING JOINTS: Glued _____ Clamped _____
 2 PVC 4 ABS 6 Asbestos-Cement 9 Other (specify below) Welded _____
 7 Fiberglass _____ Threaded **Flush**
 Blank casing diameter: **5** in. to _____ ft., Dia _____ in. to _____ ft., Dia _____ in. to _____ ft.
 Casing height above land surface: **Flush** in., weight **6.5** lbs./ft. Wall thickness or gauge No. **schd 5/40**
 TYPE OF SCREEN OR PERFORATION MATERIAL:
 1 Steel 3 Stainless steel 5 Fiberglass 8 RMP (SR) 10 Asbestos-cement
 2 Brass 4 Galvanized steel 6 Concrete tile 9 ABS 12 None used (open hole)
 SCREEN OR PERFORATION OPENINGS ARE:
 1 Continuous slot 3 Mill slot 5 Gauzed wrapped 8 Saw cut 11 None (open hole)
 2 Louvered shutter 4 Key punched 6 Wire wrapped 9 Drilled holes
 7 Torch cut 10 Other (specify) _____
 SCREEN-PERFORATED INTERVALS: From **21.0** ft. to **61.0** ft., From _____ ft. to _____ ft.
 GRAVEL PACK INTERVALS: From **20.0** ft. to **61.0** ft., From _____ ft. to _____ ft.

6 GROUT MATERIAL: 1 Neat cement 2 Cement grout 3 Bentonite 4 Other _____
 Grout Intervals: From **20.0** ft. to **0.0** ft., From _____ ft. to _____ ft., From _____ ft. to _____ ft.
 What is the nearest source of possible contamination:
 1 Septic tank 4 Lateral lines 7 Pit privy 10 Livestock pens 14 Abandoned water well
 2 Sewer lines 5 Cess pool 8 Sewage lagoon 11 Fuel storage 15 Oil well/Gas well
 3 Watertight sewer lines 6 Seepage pit 9 Feedyard 12 Fertilizer storage 16 Other (specify below)
 13 Insecticide storage **NA**
 Direction from well? **NA** How many feet? **NA**

FROM	TO	LITHOLOGIC LOG	FROM	TO	PLUGGING INTERVALS
0.0	0.5	Concrete			
0.5	2.0	FILL SAND			
2.0	22.0	Silty Clay w/ Caliche nodules			
22.0	35.0	Clay, slightly silty w/ caliche nodules			
35.0	43.0	Clay, slightly silty			
43.0	49.0	sand, fine to coarse grained			
49.0	55.0	Clay, slightly silty			
55.0	58.5	Sand, fine to coarse grained			
58.5	61.0	Shale			
Flush mount waiver granted on 12-22-92 by Don Taylor					

7 CONTRACTOR'S OR LANDOWNER'S CERTIFICATION: This water well was constructed, reconstructed, or plugged under my jurisdiction and was completed on (mo/day/year) **3-17-93** and this record is true to the best of my knowledge and belief. Kansas Water Well Contractor's License No. **531** This Water Well Record was completed on (mo/day/yr) **4-7-93** under the business name of **GSI** by (signature) **Kevin W. Johnson**

INSTRUCTIONS: Use typewriter or ball point pen. PLEASE PRESS FIRMLY and PRINT clearly. Please fill in blanks, underline or circle the correct answers. Send top three copies to Kansas Department of Health and Environment, Bureau of Water, Topeka, Kansas 66620-0001. Telephone: 913-296-5545. Send one to WATER WELL OWNER and retain one for your records.

OFFICE USE ONLY

T

R

EW

SEC.

1/4

1/4

1/4