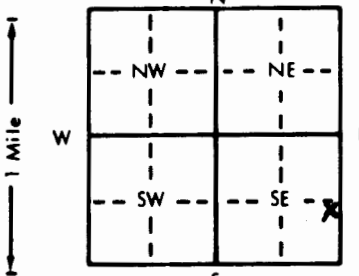


1 LOCATION OF WATER WELL: County: SEDGWICK Fraction: SE 1/4 SE 1/4 NE 1/4 Section Number: 11 Township Number: T 28 S Range Number: R 1 EW

Distance and direction from nearest town or city street address of well if located within city?
PLANT 2- BOEING

2 WATER WELL OWNER: BOEING
RR#, St. Address, Box #: P.O. Box 7730
City, State, ZIP Code: WICHITA, KS 67277-7730

Board of Agriculture, Division of Water Resources
Application Number:

3 LOCATE WELL'S LOCATION WITH AN "X" IN SECTION BOX:


4 DEPTH OF COMPLETED WELL: 67.5 ft. ELEVATION: ft.
Depth(s) Groundwater Encountered: 1. 34.0 ft. 2. ft. 3. ft.
WELL'S STATIC WATER LEVEL: 248.1 ft. below land surface measured on mo/day/yr 2-27-93
Pump test data: Well water was ft. after hours pumping gpm
Est. Yield gpm: Well water was ft. after hours pumping gpm
Bore Hole Diameter: 8.25 in. to ft., and in. to ft.
WELL WATER TO BE USED AS:
1 Domestic 3 Feedlot 6 Oil field water supply 9 Dewatering 12 Other (Specify below)
2 Irrigation 4 Industrial 7 Lawn and garden only 10 Monitoring well
Was a chemical/bacteriological sample submitted to Department? Yes..... No X..... If yes, mo/day/yr sample was submitted
Water Well Disinfected? Yes..... No X.....

5 TYPE OF BLANK CASING USED:
1 Steel 3 RMP (SR) 5 Wrought iron 8 Concrete tile CASING JOINTS: Glued..... Clamped.....
2 PVC 4 ABS 6 Asbestos-Cement 9 Other (specify below) Welded
Blank casing diameter 5 in. to ft., Dia. in. to ft., Dia. in. to ft.
Casing height above land surface: Flush 0 in., weight 6.5 lbs./ft. Wall thickness or gauge No. Schd 5/40
TYPE OF SCREEN OR PERFORATION MATERIAL:
1 Steel 3 Stainless steel 5 Fiberglass 8 RMP (SR) 10 Asbestos-cement
2 Brass 4 Galvanized steel 6 Concrete tile 9 ABS 11 Other (specify)
12 None used (open hole)
SCREEN OR PERFORATION OPENINGS ARE:
1 Continuous slot 3 Mill slot 5 Gauzed wrapped 8 Saw cut 11 None (open hole)
2 Louvered shutter 4 Key punched 6 Wire wrapped 9 Drilled holes
3 Torch cut 10 Other (specify)
SCREEN-PERFORATED INTERVALS: From 26 ft. to 67.5 ft., From ft. to ft.
GRAVEL PACK INTERVALS: From 25 ft. to 67.5 ft., From ft. to ft.
From ft. to ft., From ft. to ft.

6 GROUT MATERIAL: 25 1 Neat cement 0 2 Cement grout 3 Bentonite 4 Other
Grout Intervals: From 25 ft. to 0 ft., From ft. to ft., From ft. to ft.
What is the nearest source of possible contamination:
1 Septic tank 4 Lateral lines 7 Pit privy 10 Livestock pens 14 Abandoned water well
2 Sewer lines 5 Cess pool 8 Sewage lagoon 11 Fuel storage 15 Oil well/Gas well
3 Watertight sewer lines 6 Seepage pit 9 Feedyard 12 Fertilizer storage 16 Other (specify below)
13 Insecticide storage
Direction from well? NA How many feet? NA

FROM	TO	LITHOLOGIC LOG	FROM	TO	PLUGGING INTERVALS
0.0	1.5	Concrete			
1.5	4.0	Silty clay, some fine-med. sand			
4.0	10.0	Clay-silty, caliche concretions up to 1" in diameter			
10.0	32.0	Clay, silty, very moist, firm, magnesium staining			
32.0	36.0	Sand in clay			
36.0	51.0	Silty sand, interbedded in clay			
51.0	54.0	Clay, olive green, iron staining			
54.0	59.0	Sand, well cemented			
59.0	61.0	Clay, olive-green			
61.0	64.0	Sand or limestone, very hard			
64.0	67.5	Shale, dark grey, hard			

Flush mount waiver granted on 12-22-92 by Don Taylor

7 CONTRACTOR'S OR LANDOWNER'S CERTIFICATION: This water well was (1) constructed, (2) reconstructed, or (3) plugged under my jurisdiction and was completed on (mo/day/year) 3-17-93 and this record is true to the best of my knowledge and belief. Kansas Water Well Contractor's License No. 531 This Water Well Record was completed on (mo/day/yr) 4-7-93 under the business name of GSI by (signature) Kevin W. Johnson

INSTRUCTIONS: Use typewriter or ball point pen. PLEASE PRESS FIRMLY and PRINT clearly. Please fill in blanks, underline or circle the correct answers. Send top three copies to Kansas Department of Health and Environment, Bureau of Water, Topeka, Kansas 66620-0001. Telephone: 913-296-5545. Send one to WATER WELL OWNER and retain one for your records.

OFFICE USE ONLY
T
R
EW
SEC.