

MW 144

2011065 WATER WELL RECORD Form WWC-5 KSA 82a-1212

1 LOCATION OF WATER WELL:	Fraction	Section Number	Township Number	Range Number
County: <u>Sedgwick</u>	<u>SE 1/4 SW 1/4 SE 1/4</u>	<u>11</u>	<u>T 28 S</u>	<u>R 1 E/W</u>


Distance and direction from nearest town or city street address of well if located within city?

Materials Bldg - Boeing

2 WATER WELL OWNER:	Board of Agriculture, Division of Water Resources
RR#, St. Address, Box #:	Application Number:
City, State, ZIP Code:	

Boeing
P.O. Box
Wichita KS 67277-7730

3 LOCATE WELL'S LOCATION WITH AN "X" IN SECTION BOX:	4 DEPTH OF COMPLETED WELL: <u>64</u> ft. ELEVATION: <u>43</u> ft.
--	---

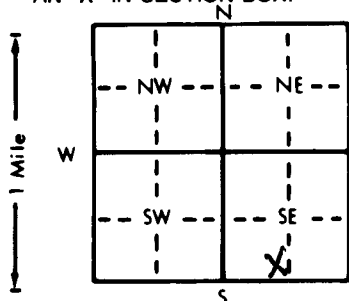

Depth(s) Groundwater Encountered	1. <u>43</u> ft.	2. _____ ft.	3. _____ ft.
WELL'S STATIC WATER LEVEL	<u>31.67</u> ft. below land surface measured on mo/day/yr	<u>1-8-93</u>	
Pump test data:	Well water was _____ ft. after _____ hours pumping _____ gpm		
Est. Yield	_____ gpm: Well water was _____ ft. after _____ hours pumping _____ gpm		
Bore Hole Diameter	<u>8</u> in. to _____ ft. and _____ in. to _____ ft.		
WELL WATER TO BE USED AS:	5 Public water supply	8 Air conditioning	11 Injection well
1 Domestic	3 Feedlot	6 Oil field water supply	9 Dewatering
2 Irrigation	4 Industrial	7 Lawn and garden only	10 <u>Monitoring well</u>
12 Other (Specify below)			
Was a chemical/bacteriological sample submitted to Department? Yes _____ No <u>X</u> _____; If yes, mo/day/yr sample was submitted _____			
Water Well Disinfected? Yes _____ No <u>X</u> _____			

5 TYPE OF BLANK CASING USED:	5 Wrought iron	8 Concrete tile	CASING JOINTS: Glued _____ Clamped _____
------------------------------	----------------	-----------------	--

1 Steel	3 RMP (SR)	6 Asbestos-Cement	9 Other (specify below)	Welded _____
<u>2 PVC</u>	4 ABS	7 Fiberglass		<u>Threaded</u> <u>Flush</u>
Blank casing diameter	<u>2</u> in. to _____ ft., Dia _____ in. to _____ ft., Dia _____ in. to _____ ft.			
Casing height above land surface	<u>Flush</u> in., weight _____ lbs./ft.	Wall thickness or gauge No. <u>154</u>		

TYPE OF SCREEN OR PERFORATION MATERIAL:	7 <u>PVC</u>	10 Asbestos-cement		
1 Steel	3 Stainless steel	5 Fiberglass	8 RMP (SR)	11 Other (specify)
2 Brass	4 Galvanized steel	6 Concrete tile	9 ABS	12 None used (open hole)

SCREEN OR PERFORATION OPENINGS ARE:	5 Gauzed wrapped	8 Saw cut	11 None (open hole)
1 Continuous slot	<u>3 Mill slot</u>	6 Wire wrapped	9 Drilled holes
2 Louvered shutter	4 Key punched	7 Torch cut	10 Other (specify)

SCREEN-PERFORATED INTERVALS:	From <u>24</u> ft. to <u>64</u> ft.	From _____ ft. to _____ ft.
GRAVEL PACK INTERVALS:	From <u>23</u> ft. to <u>64</u> ft.	From _____ ft. to _____ ft.

6 GROUT MATERIAL:	1 Neat cement	2 Cement grout	<u>3 Bentonite</u>	4 Other _____
Grout Intervals:	From <u>23</u> ft. to <u>1</u> ft.	From _____ ft. to _____ ft.	From _____ ft. to _____ ft.	From _____ ft. to _____ ft.

What is the nearest source of possible contamination:	10 Livestock pens	14 Abandoned water well	
1 Septic tank	4 Lateral lines	11 Fuel storage	15 Oil well/Gas well
2 Sewer lines	5 Cess pool	12 Fertilizer storage	16 Other (specify below)
3 Watertight sewer lines	6 Seepage pit	13 Insecticide storage	<u>NA</u>
7 Pit privy	8 Sewage lagoon	How many feet? <u>NA</u>	
9 Feedyard			

Direction from well? <u>NA</u>				
--------------------------------	--	--	--	--

FROM	TO	LITHOLOGIC LOG	FROM	TO	PLUGGING INTERVALS
<u>0.0</u>	<u>0.5</u>	<u>Concrete</u>			
<u>0.5</u>	<u>14.0</u>	<u>Clay, silty</u>			
<u>14.0</u>	<u>19.0</u>	<u>Clay</u>			
<u>19.0</u>	<u>24.0</u>	<u>Clay, silty</u>			
<u>24.0</u>	<u>35.0</u>	<u>Clay</u>			
<u>35.0</u>	<u>53.0</u>	<u>Clay, silty</u>			
<u>53.0</u>	<u>61.0</u>	<u>Clay</u>			
<u>61.0</u>	<u>64.0</u>	<u>Shale</u>			
<u>Flush mount waiver granted 12-22-93</u> <u>for Boeing by Don Taylor</u>					

7 CONTRACTOR'S OR LANDOWNER'S CERTIFICATION: This water well was (1) constructed, (2) reconstructed, or (3) plugged under my jurisdiction and was completed on (mo/day/year) <u>3-9-93</u> and this record is true to the best of my knowledge and belief. Kansas Water Well Contractor's License No. <u>531</u> This Water Well Record was completed on (mo/day/yr) <u>4-7-93</u> under the business name of <u>GSI</u> by (signature) <u>Allison V...</u>

INSTRUCTIONS: Use typewriter or ball point pen. PLEASE PRESS FIRMLY and PRINT clearly. Please fill in blanks, underline or circle the correct answers. Send top three copies to Kansas Department of Health and Environment, Bureau of Water, Topeka, Kansas 66620-0001. Telephone: 913-296-5545. Send one to WATER WELL OWNER and retain one for your records.