


1 LOCATION OF WATER WELL: Fraction NW 1/4 NW 1/4 NW 1/4 Section Number 12 Township Number T 28 S Range Number R 1 EW

Distance and direction from nearest town or city street address of well if located within city?
 42' E & 30' N of Southeast Corner of Building 23L, Boeing, Wichita, Kansas 52905010 MW-67

2 WATER WELL OWNER: Boeing Military Airplanes
 RR#, St. Address, Box #: P.O. Box 7730, M/S K06-00 Board of Agriculture, Division of Water Resources
 City, State, ZIP Code: Wichita, Kansas 67277-7730 Application Number:

3 LOCATE WELL'S LOCATION WITH AN "X" IN SECTION BOX: 4 DEPTH OF COMPLETED WELL: 63 ft. ELEVATION: Approx. Surface Elevation: 1362

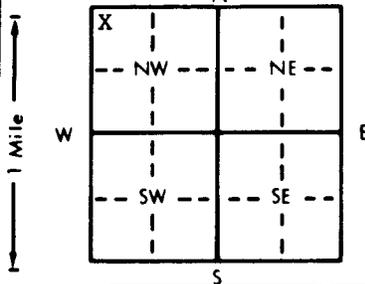

Depth(s) Groundwater Encountered 1. 14 ft. 2. ft. 3. ft.
 WELL'S STATIC WATER LEVEL ... 10.4 ft. below land surface measured on mo/day/yr Q5/22/90
 Pump test data: Well water was ft. after hours pumping gpm
 Est. Yield ... N/A gpm: Well water was ft. after hours pumping gpm
 Bore Hole Diameter ... 11 in. to 63 ft., and in. to ft.
 WELL WATER TO BE USED AS:
 5 Public water supply 8 Air conditioning 11 Injection well
 1 Domestic 3 Feedlot 6 Oil field water supply 9 Dewatering 12 Other (Specify below)
 2 Irrigation 4 Industrial 7 Lawn and garden only 10 Monitoring well
 Was a chemical/bacteriological sample submitted to Department? Yes No X; If yes, mo/day/yr sample was submitted
 Water Well Disinfected? Yes No X

5 TYPE OF BLANK CASING USED:
 1 Steel 3 RMP (SR) 5 Wrought iron 8 Concrete tile CASING JOINTS: Glued Clamped
 2 PVC 4 ABS 6 Asbestos-Cement 9 Other (specify below) Welded
 7 Fiberglass Threaded X

Blank casing diameter 4 in. to 12.5 ft., Dia in. to ft., Dia in. to ft.
 Casing height above land surface 22 in., weight lbs./ft. Wall thickness or gauge No. Schedule 40

TYPE OF SCREEN OR PERFORATION MATERIAL:
 1 Steel 3 Stainless steel 5 Fiberglass 7 PVC 10 Asbestos-cement
 2 Brass 4 Galvanized steel 6 Concrete tile 8 RMP (SR) 11 Other (specify)
 12 None used (open hole)

SCREEN OR PERFORATION OPENINGS ARE:
 1 Continuous slot 3 Mill slot 5 Gauzed wrapped 8 Saw cut 11 None (open hole)
 2 Louvered shutter 4 Key punched 6 Wire wrapped 9 Drilled holes
 7 Torch cut 10 Other (specify)

SCREEN-PERFORATED INTERVALS: From 12.5 ft. to 62.5 ft., From ft. to ft.
 From ft. to ft., From ft. to ft.
 GRAVEL PACK INTERVALS: From 11 ft. to 63 ft., From ft. to ft.
 From ft. to ft., From ft. to ft.

6 GROUT MATERIAL: 1 Neat cement 2 Cement grout 3 Bentonite 4 Other
 Grout Intervals: From 0 ft. to 9 ft., From 9 ft. to 11 ft., From ft. to ft.

What is the nearest source of possible contamination:
 1 Septic tank 4 Lateral lines 7 Pit privy 10 Livestock pens 14 Abandoned water well
 2 Sewer lines 5 Cess pool 8 Sewage lagoon 11 Fuel storage 15 Oil well/Gas well
 3 Watertight sewer lines 6 Seepage pit 9 Feedyard 12 Fertilizer storage 16 Other (specify below)
 13 Insecticide storage

Direction from well? N How many feet? 40

| FROM | TO | LITHOLOGIC LOG | FROM | TO | PLUGGING INTERVALS |
|------|------|--------------------------------------|------|----|--------------------|
| 0 | 5.0 | Red-Brown Fat Clay | | | |
| 5.0 | 14.0 | Red-Brown to Olive-Gray Fat Clay | | | |
| 14.0 | 30.0 | Red-Brown Lean to Fat Clay with Sand | | | |
| 30.0 | 60.0 | Red-Brown Fat Clay | | | |
| 60.0 | 63.0 | Dark Gray Weathered Shale | | | |

7 CONTRACTOR'S OR LANDOWNER'S CERTIFICATION: This water well was (1) constructed, (2) reconstructed, or (3) plugged under my jurisdiction and was completed on (mo/day/year) 02/21/90 and this record is true to the best of my knowledge and belief. Kansas Water Well Contractor's License No. 416 This Water Well Record was completed on (mo/day/yr) 1/27/99 under the business name of Terracon Consultants, Inc. by (signature)