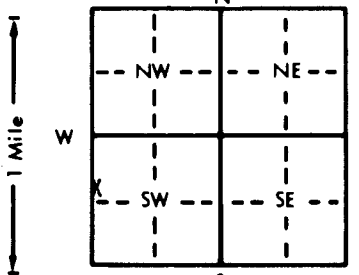


1 LOCATION OF WATER WELL:		Fraction		Section Number		Township Number		Range Number	
County: Sedgwick		SW 1/4 NW 1/4 SW 1/4		13		T 28 S		R 1 EW	
Distance and direction from nearest town or city street address of well if located within city?									
1570' N. of the intersection of Oliver and 47th Street South, Wichita, KS						52895017		MW-1	
2 WATER WELL OWNER: Boeing Military Airplanes									
RR#, St. Address, Box # : P. O. Box 7730, M/S K06-00									
City, State, ZIP Code : Wichita, KS 67277-7730									
Board of Agriculture, Division of Water Resources									
Application Number:									
3 LOCATE WELL'S LOCATION WITH AN "X" IN SECTION BOX:		4 DEPTH OF COMPLETED WELL 51 ft. ELEVATION: Approx. Surface Elev: 1327.3							
		Depth(s) Groundwater Encountered 1. 14.5 ft. 2. ft. 3. ft.							
		WELL'S STATIC WATER LEVEL 13.4 ft. below land surface measured on mo/day/yr 05/03/89							
		Pump test data: Well water was ft. after hours pumping gpm							
		Est. Yield N/A gpm: Well water was ft. after hours pumping gpm							
		Bore Hole Diameter 9 in. to 51.5 ft. and in. to ft.							
WELL WATER TO BE USED AS:									
5 Public water supply 8 Air conditioning 11 Injection well									
1 Domestic 3 Feedlot 6 Oil field water supply 9 Dewatering 12 Other (Specify below)									
2 Irrigation 4 Industrial 7 Lawn and garden only 10 Monitoring well									
Was a chemical/bacteriological sample submitted to Department? Yes No X If yes, mo/day/yr sample was submitted									
Water Well Disinfected? Yes No X									
5 TYPE OF BLANK CASING USED:									
1 Steel 3 RMP (SR) 5 Wrought iron 8 Concrete tile CASING JOINTS: Glued Clamped									
2 PVC 4 ABS 6 Asbestos-Cement 9 Other (specify below) Welded									
7 Fiberglass Threaded									
Blank casing diameter in. to ft. Dia in. to ft. Dia in. to ft.									
Casing height above land surface in. weight lbs./ft. Wall thickness or gauge No.									
TYPE OF SCREEN OR PERFORATION MATERIAL:									
1 Steel 3 Stainless steel 5 Fiberglass 7 PVC 10 Asbestos-cement									
2 Brass 4 Galvanized steel 6 Concrete tile 8 RMP (SR) 11 Other (specify)									
9 ABS 12 None used (open hole)									
SCREEN OR PERFORATION OPENINGS ARE:									
1 Continuous slot 3 Mill slot 5 Gauzed wrapped 8 Saw cut 11 None (open hole)									
2 Louvered shutter 4 Key punched 6 Wire wrapped 9 Drilled holes									
7 Torch cut 10 Other (specify)									
SCREEN-PERFORATED INTERVALS: From ft. to ft. From ft. to ft.									
GRAVEL PACK INTERVALS: From ft. to ft. From ft. to ft.									
6 GROUT MATERIAL: 1 Neat cement 2 Cement grout 3 Bentonite 4 Other									
Grout Intervals: From 0 ft. to 51 ft. From ft. to ft. From ft. to ft.									
What is the nearest source of possible contamination:									
1 Septic tank 4 Lateral lines 7 Pit privy 10 Livestock pens 14 Abandoned water well									
2 Sewer lines 5 Cess pool 8 Sewage lagoon 11 Fuel storage 15 Oil well/Gas well									
3 Watertight sewer lines 6 Seepage pit 9 Feedyard 12 Fertilizer storage 16 Other (specify below)									
13 Insecticide storage Concrete Mixing Plant									
Direction from well? S How many feet? 1240'									
FROM TO LITHOLOGIC LOG FROM TO PLUGGING INTERVALS									
0 14.5 Brown to Red-Brown Lean Clay with Silt									
14.5 19 Red-Brown and Light Gray Lean Clay with Layers of White Silty Material									
19 21.5 Mottled Gray Lean to Fat Clay with Sand									
21.5 40 Red-Brown to Gray-Brown Lean to Fat Clay									
40 46 Fat to Lean Clay with Calcareous Material and Gravel									
46 48.5 Olive-Gray Highly Weathered Shale									
48.5 51.5 Gray Weathered Shale									
WELL CASING WAS REMOVED, BORING RE-DRILLED AND FILLED WITH BENTONITE-CEMENT GROUT ON 07/28/89.									
7 CONTRACTOR'S OR LANDOWNER'S CERTIFICATION: This water well was (1) constructed, (2) reconstructed, or (3) plugged under my jurisdiction and was completed on (mo/day/year) 07/28/89 and this record is true to the best of my knowledge and belief. Kansas Water Well Contractor's License No. 416 This Water Well Record was completed on (mo/day/yr) 10/17/89 under the business name of Terracon Consultants, Inc. by (signature)									
INSTRUCTIONS: Use typewriter or ball point pen. PLEASE PRESS FIRMLY and PRINT clearly. Please fill in blanks, underline or circle the correct answers. Send two copies to Kansas Department of Health and Environment, Bureau of Water Protection, Topeka, Kansas 66620-7320. Telephone: 913-296-5514. Send one to WATER WELL OWNER and retain one for your records.									