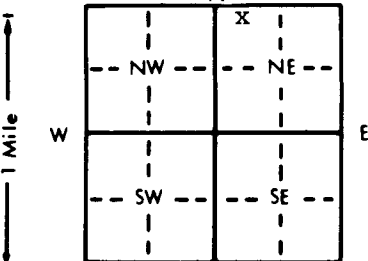


WATER WELL RECORD Form WWC-5 KSA 82a-1212

1 LOCATION OF WATER WELL:		Fraction NW 1/4 NW 1/4 NE 1/4		Section Number 14		Township Number T 28 S		Range Number R 1 E/W	
Distance and direction from nearest town or city street address of well if located within city? Approximately 1/8 miles south and 1/8 mile east of Wichita	
2 WATER WELL OWNER: Boeing Company RR#, St. Address, Box # : 3801 S. Oliver City, State, ZIP Code : Wichita, KS 67210 Board of Agriculture, Division of Water Resources Application Number: N/A	
3 LOCATE WELL'S LOCATION WITH AN "X" IN SECTION BOX:			4 DEPTH OF COMPLETED WELL 48.5 ft. ELEVATION: unknown	
			Depth(s) Groundwater Encountered 1. ft. 2. ft. 3. ft.	
			WELL'S STATIC WATER LEVEL 15.4 ft. below land surface measured on mo/day/yr 8-13-92	
			Pump test data: Well water was not ch'd. ft. after hours pumping gpm	
			Est. Yield unknown gpm: Well water was ft. after hours pumping gpm	
Blank casing diameter 5 in. to 24 in., weight 2.87 lbs./ft.			Bore Hole Diameter 11 in. to 48.5 ft., and in. to ft.	
5 TYPE OF BLANK CASING USED: 1 Steel 3 RMP (SR) 5 Wrought iron 8 Concrete tile CASING JOINTS: Glued X Clamped 2 PVC 4 ABS 6 Asbestos-Cement 9 Other (specify below) Welded 7 Fiberglass Threaded	
TYPE OF SCREEN OR PERFORATION MATERIAL: 1 Steel 3 Stainless steel 5 Fiberglass 7 PVC 10 Asbestos-cement 2 Brass 4 Galvanized steel 6 Concrete tile 8 RMP (SR) 11 Other (specify) 9 ABS 12 None used (open hole)	
SCREEN OR PERFORATION OPENINGS ARE: 1 Continuous slot 3 Mill slot 5 Gauzed wrapped 8 Saw cut 11 None (open hole) 2 Louvered shutter 4 Key punched 6 Wire wrapped 9 Drilled holes 7 Torch cut 10 Other (specify)	
SCREEN-PERFORATED INTERVALS: From 18 ft. to 46.5 ft. From ft. to ft. From ft. to ft. From ft. to ft.	
GRAVEL PACK INTERVALS: From 16 ft. to 48.5 ft. From ft. to ft. From ft. to ft. From ft. to ft.	
6 GROUT MATERIAL: 1 Neat cement 2 Cement grout 3 Bentonite 4 Other Bentonite Holeplug Grout Intervals: From ft. to ft. From ft. to ft. From 0 ft. to 16 ft.	
What is the nearest source of possible contamination: 1 Septic tank 4 Lateral lines 7 Pit privy 10 Livestock pens 14 Abandoned water well 2 Sewer lines 5 Cess pool 8 Sewage lagoon 11 Fuel storage 15 Oil well/Gas well 3 Watertight sewer lines 6 Seepage pit 9 Feedyard 12 Fertilizer storage 16 Other (specify below) Ground Already Contaminated Direction from well? How many feet?	
<table border="1"><thead><tr><th>FROM</th><th>TO</th><th>LITHOLOGIC LOG</th><th>FROM</th><th>TO</th><th>PLUGGING INTERVALS</th></tr></thead><tbody><tr><td>0</td><td>8</td><td>Fill, clay, black and sand</td><td></td><td></td><td></td></tr><tr><td>8</td><td>19</td><td>Clay, Tan</td><td></td><td></td><td></td></tr><tr><td>19</td><td>22</td><td>Clay, tan</td><td></td><td></td><td></td></tr><tr><td>22</td><td>26</td><td>Clay, tan with caliche with sand mixed</td><td></td><td></td><td></td></tr><tr><td>26</td><td>38</td><td>Clay, tan with caliche, a lot of thin streaks of sand, fine with some gravel fine, sand streaks were loose</td><td></td><td></td><td></td></tr><tr><td>27.5</td><td></td><td>Very thin streak of limestone, white</td><td></td><td></td><td></td></tr><tr><td>38</td><td>45.5</td><td>Clay, green, yellow, red</td><td></td><td></td><td></td></tr><tr><td>45.5</td><td>48.5</td><td>Shale, gray, soft</td><td></td><td></td><td></td></tr>
7 CONTRACTOR'S OR LANDOWNER'S CERTIFICATION: This water well was (1) constructed, (2) reconstructed, or (3) plugged under my jurisdiction and was completed on (mo/day/year) 6-12-92 and this record is true to the best of my knowledge and belief. Kansas Water Well Contractor's License No. 185 This Water Well Record was completed on (mo/day/yr) 2-24-93 under the business name of Clarke Well & Equipment, Inc. by (signature) [Signature]	
INSTRUCTIONS: Use typewriter or ball point pen. PLEASE PRESS FIRMLY and PRINT clearly. Please fill in blanks, underline or circle the correct answers. Send top three copies to Kansas Department of Health and Environment, Bureau of Water, Topeka, Kansas 66620-0001. Telephone: 913-296-5545. Send one to WATER WELL OWNER and retain one for your records.	