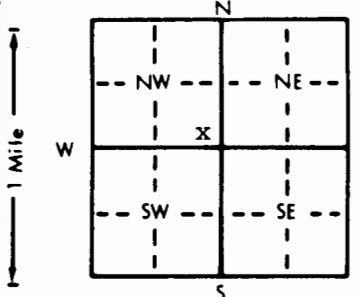


1 LOCATION OF WATER WELL:		Fraction		Section Number		Township Number		Range Number	
County: Sedgwick		SE 1/4 SE 1/4 NW 1/4		14		T 28 S		R 1 EXM	
Distance and direction from nearest town or city street address of well if located within city?									
Approximately 1/8 mile south and 1/8 mile east of Wichita									
2 WATER WELL OWNER:		Boeing Company							
RR#, St. Address, Box # :		3801 S. Oliver							
City, State, ZIP Code :		Wichita, KS 67210							
		Board of Agriculture, Division of Water Resources							
		Application Number: N/A							
3 LOCATE WELL'S LOCATION WITH AN "X" IN SECTION BOX:		4 DEPTH OF COMPLETED WELL: 50.5 ft. ELEVATION: unknown							
		Depth(s) Groundwater Encountered 1. ft. 2. ft. 3. ft.							
		WELL'S STATIC WATER LEVEL: 19.5 ft. below land surface measured on mo/day/yr 11-10-92							
		Pump test data: Well water was not ch'd. ft. after hours pumping gpm							
		Est. Yield unknown gpm: Well water was ft. after hours pumping gpm							
		Bore Hole Diameter: 11 in. to 50.5 ft., and in. to ft.							
		WELL WATER TO BE USED AS:							
		5 Public water supply 8 Air conditioning 11 Injection well							
		1 Domestic 3 Feedlot 6 Oil field water supply 9 Dewatering 12 Other (Specify below)							
		2 Irrigation 4 Industrial 7 Lawn and garden only 10 Monitoring well Recovery							
		Was a chemical/bacteriological sample submitted to Department? Yes No X; If yes, mo/day/yr sample was submitted							
		Water Well Disinfected? Yes No X							
5 TYPE OF BLANK CASING USED:		5 Wrought iron 8 Concrete tile CASING JOINTS: Glued X Clamped							
1 Steel 3 RMP (SR)		6 Asbestos-Cement 9 Other (specify below) Welded							
2 PVC 4 ABS		7 Fiberglass Threaded							
Blank casing diameter 5 in. to 14 ft., Dia in. to ft., Dia in. to ft.									
Casing height above land surface 24 in., weight 2.87 lbs./ft. Wall thickness or gauge No. 265									
TYPE OF SCREEN OR PERFORATION MATERIAL:		7 PVC 10 Asbestos-cement							
1 Steel 3 Stainless steel 5 Fiberglass 8 RMP (SR) 11 Other (specify)									
2 Brass 4 Galvanized steel 6 Concrete tile 9 ABS 12 None used (open hole)									
SCREEN OR PERFORATION OPENINGS ARE:		5 Gauzed wrapped 8 Saw cut 11 None (open hole)							
1 Continuous slot 3 Mill slot 6 Wire wrapped 9 Drilled holes									
2 Louvered shutter 4 Key punched 7 Torch cut 10 Other (specify)									
SCREEN-PERFORATED INTERVALS: From 14 ft. to 48.5 ft., From ft. to ft.									
GRAVEL PACK INTERVALS: From 12 ft. to 50.5 ft., From ft. to ft.									
6 GROUT MATERIAL:		1 Neat cement 2 Cement grout 3 Bentonite 4 Other Bentonite Holeplug							
Grout Intervals: From ft. to ft., From ft. to ft., From 0 ft. to 12 ft.									
What is the nearest source of possible contamination:		10 Livestock pens 14 Abandoned water well							
1 Septic tank 4 Lateral lines 7 Pit privy 11 Fuel storage 15 Oil well/Gas well									
2 Sewer lines 5 Cess pool 8 Sewage lagoon 12 Fertilizer storage 16 Other (specify below)									
3 Watertight sewer lines 6 Seepage pit 9 Feedyard 13 Insecticide storage Ground already contaminated									
Direction from well?		How many feet?							
FROM	TO	LITHOLOGIC LOG		FROM	TO	PLUGGING INTERVALS			
0	2	Topsoil				very fine cobble mixed			
2	5	Clay, brown, soft, silty		47.5	50.5	Shale, gray, soft			
5	11	Clay, brown, tight							
11	13	Clay, dark brown							
13	20	Clay, reddish-brown, soft							
20	28	Clay, reddish-brown with caliche							
28	36.5	Clay, tan, tight with very thin streak of sand at 33.5', one more thin streak of sand between 33.5' and 35'							
36.5	39	Clay, tan, sandy with very fine cobble mixed, tight							
39	43	Clay, tan with a couple very thin streaks of sand at 41' - 43'							
43	47.5	Clay, green with some sand and							
7 CONTRACTOR'S OR LANDOWNER'S CERTIFICATION: This water well was (1) constructed, (2) reconstructed, or (3) plugged under my jurisdiction and was completed on (mo/day/year) 7-6-92 and this record is true to the best of my knowledge and belief. Kansas Water Well Contractor's License No. 185 This Water Well Record was completed on (mo/day/yr) 2-25-93 under the business name of Clarke Well & Equipment, Inc. by (signature)									