


1 LOCATION OF WATER WELL: County: Sedgwick Fraction SE 1/4 NE 1/4 SE 1/4 Section Number 14 Township Number T 28 S Range Number R 1 **EW**

Distance and direction from nearest town or city street address of well if located within city? 40' South of 4605 S.Oliver, Wichita, KS
 State Plane Coordinates 1,665,741.750 E 1,658,066.479 **WN** MW-116

2 WATER WELL OWNER: Boeing Commercial Airplane Group Project No. 52925020
 RR#, St. Address, Box #: P.O. Box 7730 M/S K11-65 Board of Agriculture, Division of Water Resources
 City, State, ZIP Code: Wichita, Kansas 67277-7730 Application Number:

3 LOCATE WELL'S LOCATION WITH AN "X" IN SECTION BOX:

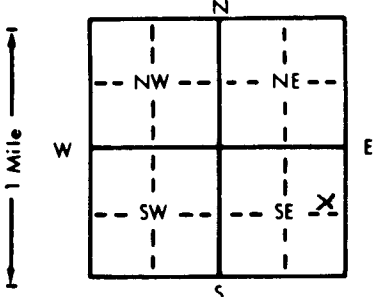

4 DEPTH OF COMPLETED WELL: 62.5 ft. ELEVATION: 1335.8
 Depth(s) Groundwater Encountered 1. 18.5 ft. 2. ft. 3. 3/9/92 ft.
 WELL'S STATIC WATER LEVEL: 16.7 ft. below land surface measured on mo/day/yr
 Pump test data: Well water was NA ft. after hours pumping gpm
 Est. Yield NA gpm: Well water was ft. after hours pumping gpm
 Bore Hole Diameter: 8.2 in. to 62.5 ft., and in. to ft.
 WELL WATER TO BE USED AS: 5 Public water supply 8 Air conditioning 11 Injection well
 1 Domestic 3 Feedlot 6 Oil field water supply 9 Dewatering 12 Other (Specify below)
 2 Irrigation 4 Industrial 7 Lawn and garden only **10** Monitoring well
 Was a chemical/bacteriological sample submitted to Department? Yes No **X**; If yes, mo/day/yr sample was submitted Water Well Disinfected? Yes No **X**

5 TYPE OF BLANK CASING USED: 1 Steel 3 RMP (SR) 5 Wrought iron 8 Concrete tile CASING JOINTS: Glued Clamped
2 PVC 4 ABS 6 Asbestos-Cement 9 Other (specify below) Welded
 7 Fiberglass Threaded **X**
 Blank casing diameter 2 in. to 12 ft., Dia in. to ft., Dia in. to ft.
 Casing height above land surface 34.7 in., weight lbs./ft. Wall thickness or gauge No.

TYPE OF SCREEN OR PERFORATION MATERIAL: **7** PVC 10 Asbestos-cement
 1 Steel 3 Stainless steel 5 Fiberglass 8 RMP (SR) 11 Other (specify)
 2 Brass 4 Galvanized steel 6 Concrete tile 9 ABS 12 None used (open hole)
 SCREEN OR PERFORATION OPENINGS ARE: 5 Gauzed wrapped 8 Saw cut 11 None (open hole)
 1 Continuous slot **3** Mill slot 6 Wire wrapped 9 Drilled holes
 2 Louvered shutter 4 Key punched 7 Torch cut 10 Other (specify)

SCREEN-PERFORATED INTERVALS: From 12 ft. to 62.0 ft., From ft. to ft.
 From ft. to ft., From ft. to ft.
 GRAVEL PACK INTERVALS: From 8 ft. to 62.5 ft., From ft. to ft.
 From ft. to ft., From ft. to ft.

6 GROUT MATERIAL: **1** Neat cement 2 Cement grout **3** Bentonite 4 Other
 Grout Intervals: From 0 ft. to 6 ft., From 6 ft. to 8 ft., From ft. to ft.
 What is the nearest source of possible contamination:
 1 Septic tank 4 Lateral lines 7 Pit privy 10 Livestock pens 14 Abandoned water well
2 Sewer lines 5 Cess pool 8 Sewage lagoon 11 Fuel storage 15 Oil well/Gas well
 3 Watertight sewer lines 6 Seepage pit 9 Feedyard 12 Fertilizer storage 16 Other (specify below)
 13 Insecticide storage
 Direction from well? How many feet?

FROM	TO	LITHOLOGIC LOG	FROM	TO	PLUGGING INTERVALS
0	1.0	Topsoil			
1.0	2.0	Brown Lean to Fat Clay w/Sand Fill			
2.0	11.0	Red Brown Sandy Lean Clay			
11.0	15.0	Lt. Brown Lean to Fat Clay			
15.0	28.0	Lt. Brown to Gray Brown Sandy Lean Clay			
28.0	29.0	Red Brown Lean to Fat Clay w/Sand			
29.0	37.0	Red Brown to Brown Lean to Fat Clay			
37.0	41.0	Lt. Brown to Red Brown Sandy Lean Clay			
41.0	54.5	Brown to Olive Brown Fat Clay			
54.5	62.5	Dark Gray Shale			

7 CONTRACTOR'S OR LANDOWNER'S CERTIFICATION: This water well was **1** constructed, (2) reconstructed, or (3) plugged under my jurisdiction and was completed on (mo/day/year) 3/4/92 and this record is true to the best of my knowledge and belief. Kansas Water Well Contractor's License No. 416 This Water Well Record was completed on (mo/day/yr) 3/2/92 under the business name of Terracon Consultants by (signature)