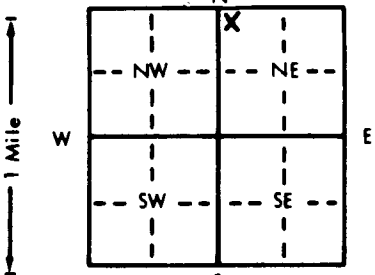


1 LOCATION OF WATER WELL:		Fraction		Section Number		Township Number		Range Number	
County: Sedgwick		SW 1/4 NW 1/4 NE 1/4		14		T 28 S		R 1 EW	
Distance and direction from nearest town or city street address of well if located within city?									
Approx 1950' West of Oliver & Approx 890' South of MacArthur, Wichita, Kansas Project No. 52915111									
2 WATER WELL OWNER: Boeing Commercial Airplane Group					MW-27				
RR#, St. Address, Box #: P.O. Box 7730 M/S K11-65					Board of Agriculture, Division of Water Resources				
City, State, ZIP Code: Wichita, Kansas 67277-7730					Application Number:				
3 LOCATE WELL'S LOCATION WITH AN "X" IN SECTION BOX:		4 DEPTH OF COMPLETED WELL: 32.0 ft. ELEVATION: 1322.9 Approx							
		Depth(s) Groundwater Encountered 1. 28.0 ft. 2. ft. 3. ft.							
		WELL'S STATIC WATER LEVEL: 28.0 ft. below land surface measured on mo/day/yr 2/14/92							
		Pump test data: Well water was ft. after hours pumping gpm							
		Est. Yield NA gpm: Well water was ft. after hours pumping gpm							
WELL WATER TO BE USED AS:		5 Public water supply 8 Air conditioning 11 Injection well							
1 Domestic 3 Feedlot 6 Oil field water supply 9 Dewatering 12 Other (Specify below)									
2 Irrigation 4 Industrial 7 Lawn and garden only 10 Monitoring well									
Was a chemical/bacteriological sample submitted to Department? Yes NA No; If yes, mo/day/yr sample was submitted									
Water Well Disinfected? Yes NA No									
5 TYPE OF BLANK CASING USED:									
1 Steel 3 RMP (SR) 5 Wrought iron 8 Concrete tile CASING JOINTS: Glued Clamped									
2 PVC 4 ABS 6 Asbestos-Cement 9 Other (specify below) Welded									
3 Fiberglass Threaded									
Blank casing diameter 4 in. to 32.0 ft., Dia in. to ft., Dia in. to ft.									
Casing height above land surface 36 in., weight lbs./ft. Wall thickness or gauge No.									
TYPE OF SCREEN OR PERFORATION MATERIAL: NA									
1 Steel 3 Stainless steel 5 Fiberglass 8 RMP (SR) 10 Asbestos-cement N/A									
2 Brass 4 Galvanized steel 6 Concrete tile 9 ABS 11 Other (specify) N/A									
12 None used (open hole)									
SCREEN OR PERFORATION OPENINGS ARE: NA									
1 Continuous slot 3 Mill slot 5 Gauzed wrapped 8 Saw cut 11 None (open hole)									
2 Louvered shutter 4 Key punched 6 Wire wrapped 9 Drilled holes									
7 Torch cut 10 Other (specify) N/A									
SCREEN-PERFORATED INTERVALS: From NA ft. to N/A ft., From ft. to ft., From ft. to ft.									
GRAVEL PACK INTERVALS: From NA ft. to ft., From ft. to ft., From ft. to ft.									
6 GROUT MATERIAL: 1 Neat cement 2 Cement grout 3 Bentonite 4 Other									
Grout Intervals: From 27 ft. to 0 ft., From ft. to ft., From ft. to ft.									
What is the nearest source of possible contamination:									
1 Septic tank 4 Lateral lines 7 Pit privy 10 Livestock pens 14 Abandoned water well									
2 Sewer lines 5 Cess pool 8 Sewage lagoon 11 Fuel storage 15 Oil well/Gas well									
3 Watertight sewer lines 6 Seepage pit 9 Feedyard 12 Fertilizer storage 16 Other (specify below) Industrial Plant									
13 Insecticide storage									
Direction from well? How many feet?									
FROM TO LITHOLOGIC LOG FROM TO PLUGGING INTERVALS									
		0 27.0 Cement Grout							
		27.0 32.0 Sand							
7 CONTRACTOR'S OR LANDOWNER'S CERTIFICATION: This water well was (1) constructed, (2) reconstructed, or (3) plugged under my jurisdiction and was completed on (mo/day/year) 2/14/92 and this record is true to the best of my knowledge and belief. Kansas Water Well Contractor's License No. 416 This Water Well Record was completed on (mo/day/yr) 3/26/94 under the business name of Terracon Consultants by (signature)									
INSTRUCTIONS: Use typewriter or ball point pen. PLEASE PRESS FIRMLY and PRINT clearly. Please fill in blanks, underline or circle the correct answer. Send top three copies to Kansas Department of Health and Environment, Bureau of Water, Topeka, Kansas 66620-0001. Telephone: 913-296-5545. Send one to WATER WELL OWNER and retain one for your records.									