


1 LOCATION OF WATER WELL:	Fraction	Section Number	Township Number	Range Number
County: <u>SEDGWICK</u>	<u>SE</u> $\frac{1}{4}$ <u>NW</u> $\frac{1}{4}$ <u>NE</u> $\frac{1}{4}$	<u>15</u>	T <u>28</u> S	R <u>1</u> E

Distance and direction from nearest town or city street address of well if located within city? RW
 1 and 1/2 miles 2801 MacArthur

2 WATER WELL OWNER: *Boeing S. Oliver*
RR#, St. Address, Box # : *380*
City, State, ZIP Code : *Wichita, KS*

3 LOCATE WELL'S LOCATION WITH AN "X" IN SECTION BOX: 4 DEPTH OF COMPLETED WELL: 30 ft. ELEVATION: 12 ft.

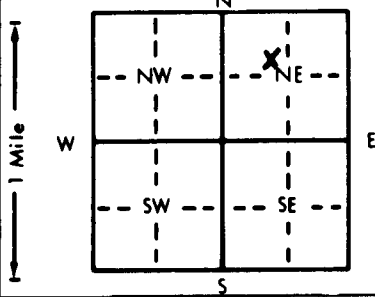

4 DEPTH OF COMPLETED WELL ft. **ELEVATION:**

Depth(s) Groundwater Encountered ft. 2. ft. 3. ft.

WELL'S STATIC WATER LEVEL ft. below land surface measured on mo/day/yr

Pump test data: Well water was ft. after hours pumping gpm

Est. Yield gpm; Well water was ft. after hours pumping gpm

Bore Hole Diameter.....12" in. to30" ft., and in. to ft.

WELL WATER TO BE USED AS:

1 Domestic	3 Feedlot	6 Oil field water supply	(9) Dewatering	11 Injection well
2 Irrigation	4 Industrial	7 Lawn and garden only	10 Monitoring well	12 Other (Specify below)

Aquifer remediation

Was a chemical/bacteriological sample submitted to Department? Yes.....No X; If yes, mo/day/yr sample was submitted

Water Well Disinfected? Yes No X

5 TYPE OF BLANK CASING USED:

1 Steel	3 RMP (SR)	5 Wrought iron	8 Concrete tile	CASING JOINTS: Glued Clamped
2 PVC	4 ABS	6 Asbestos-Cement	9 Other (specify below)	Welded
		7 Fiberglass		Threaded. ☒

Blank casing diameter 5 in. to 10 ft. Dia _____ in. to _____ ft. Dia _____ in. to _____ ft.
Casing height above land surface 12 in. weight 2.77 lbs./ft. Wall thickness or gauge No. .58

TYPE OF SCREEN OR PERFORATION MATERIAL:			7 PVC	10 Asbestos-cement
1 Steel	3 Stainless steel	5 Fiberglass	8 RMP (SR)	11 Other (specify)
2 Brass	4 Galvanized steel	6 Concrete tile	9 ABS	12 None used (open hole)

SCREEN OR PERFORATION OPENINGS ARE:

1 Continuous slot	3 Mill slot	5 Gauzed wrapped	8 Saw cut	11 None (open hole)
2 Louvered shutter	4 Key punched	6 Wire wrapped	9 Drilled holes	
		7 Torch cut	10 Other (specify)	

SCREEN-PERFORATED INTERVALS: From 10 ft. to 30 ft., From ft. to ft.
From ft. to ft., From ft. to ft.
GRAVEL PACK INTERVALS: From 8 ft. to 30 ft., From ft. to ft.
From ft. to ft., From ft. to ft.

6] GROUT MATERIAL: ① Neat cement 2 Cement grout ③ Bentonite ④ Other
Grout Intervals: From ⑧ ft. to ⑥ ft. From ⑥ ft. to ⑧ ft. From . ft. to . ft.

What is the nearest source of possible contamination: *pitless installed*

1 Septic tank	4 Lateral lines	7 Pit privy	10 Livestock pens	14 Abandoned water well
2 Sewer lines	5 Cess pool	8 Sewage lagoon	11 Fuel storage	15 Oil well/Gas well
3 Watertight sewer lines	6 Seepage pit	9 Feedyard	12 Fertilizer storage	16 Other (specify below)

Direction from well? *within land fill*

How many feet?

[illegible]

7. CONTRACTOR'S OR LANDOWNER'S CERTIFICATION: This water well was (1) constructed, (2) reconstructed, or (3) plugged under my jurisdiction and was completed on (mo/day/year) 11-16-93 and this record is true to the best of my knowledge and belief. Kansas Water Well Contractor's License No. 102 This Water Well Record was completed on (mo/day/yr) 11-18-93 under the business name of Layne, Inc by (signature) Steven E. Layne

