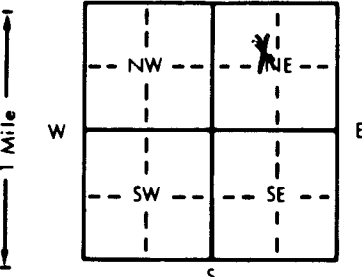


1 LOCATION OF WATER WELL: County: SEDGWICK		Fraction se 1/4 nw 1/4 ne 1/4		Section Number 16		Township Number T 28 S		Range Number R 1 E/W		
Distance and direction from nearest town or city street address of well if located within city? McArthur & Ellis Wichita, Kansas										
2 WATER WELL OWNER: Hampton & Peachin Construction RR#, St. Address, Box # : 415 So. Main City, State, ZIP Code : Wichita, Kansas Board of Agriculture, Division of Water Resources Application Number:										
3 LOCATE WELL'S LOCATION WITH AN "X" IN SECTION BOX:			4 DEPTH OF COMPLETED WELL: 35 ft. ELEVATION:							
			Depth(s) Groundwater Encountered 1. 10 ft. 2. ft. 3. ft.							
			WELL'S STATIC WATER LEVEL 10 ft. below land surface measured on mo/day/yr 7-21-83							
			Pump test data: Well water was ft. after hours pumping gpm							
			Est. Yield gpm: Well water was ft. after hours pumping gpm							
Bore Hole Diameter 11 in. to ft., and in. to ft.			WELL WATER TO BE USED AS:							
1 Domestic			3 Feedlot		6 Oil field water supply		8 Air conditioning		11 Injection well	
2 Irrigation			4 Industrial		7 Lawn and garden only		9 Dewatering		12 Other (Specify below)	
Was a chemical/bacteriological sample submitted to Department? Yes. No. X. If yes, mo/day/yr sample was submitted										
Water Well Disinfected? Yes X No										
5 TYPE OF BLANK CASING USED:										
1 Steel 3 RMP (SR) 5 Wrought iron 8 Concrete tile CASING JOINTS: Glued X Clamped										
2 PVC 4 ABS 6 Asbestos-Cement 9 Other (specify below) Welded										
Blank casing diameter 5 in. to 15 ft., Dia. in. to ft., Dia. in. to ft.										
Casing height above land surface 12 in., weight 1.59 lbs./ft. Wall thickness or gauge No. 203										
TYPE OF SCREEN OR PERFORATION MATERIAL:										
1 Steel 3 Stainless steel 5 Fiberglass 8 RMP (SR) 11 Other (specify)										
2 Brass 4 Galvanized steel 6 Concrete tile 9 ABS 12 None used (open hole)										
SCREEN OR PERFORATION OPENINGS ARE:										
1 Continuous slot 3 Mill slot 5 Gauzed wrapped 8 Saw cut 11 None (open hole)										
2 Louvered shutter 4 Key punched 6 Wire wrapped 9 Drilled holes										
7 Torch cut 10 Other (specify)										
SCREEN-PERFORATED INTERVALS: From 15 ft. to 35 ft., From ft. to ft.										
GRAVEL PACK INTERVALS: From 14 ft. to 35 ft., From ft. to ft.										
6 GROUT MATERIAL: 1 Neat cement 2 Cement grout 3 Bentonite 4 Other										
Grout Intervals: From 4 ft. to 14 ft., From ft. to ft., From ft. to ft.										
What is the nearest source of possible contamination:										
1 Septic tank 4 Lateral lines 7 Pit privy 10 Livestock pens 14 Abandoned water well										
2 Sewer lines 5 Cess pool 8 Sewage lagoon 11 Fuel storage 15 Oil well/Gas well										
3 Watertight sewer lines 6 Seepage pit 9 Feedyard 12 Fertilizer storage 16 Other (specify below)										
13 Insecticide storage None Apparent										
Direction from well? How many feet?										
FROM TO LITHOLOGIC LOG FROM TO LITHOLOGIC LOG										
0 3 Topsoil										
3 20 Fine Sand										
20 30 Medium Sand										
30 35 Grey Shale										
7 CONTRACTOR'S OR LANDOWNER'S CERTIFICATION: This water well was (1) constructed, (2) reconstructed, or (3) plugged under my jurisdiction and was completed on (mo/day/year) 7-21-83 and this record is true to the best of my knowledge and belief. Kansas Water Well Contractor's License No. 236 This Water Well Record was completed on (mo/day/yr) 10-24-83 under the business name of Harp Well & Pump Service, Inc. by (signature) Mary Arnold										
INSTRUCTIONS: Use typewriter or ball point pen, PLEASE PRESS FIRMLY and PRINT clearly. Please fill in blanks, underline or circle the correct answers. Send top three copies to Kansas Department of Health and Environment, Division of Environment, Environmental Geology Section, Topeka, KS 66620. Send one to WATER WELL OWNER and retain one for your records.										