

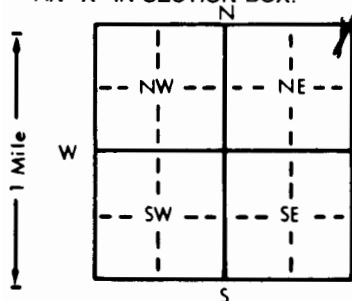
1 LOCATION OF WATER WELL:	Fraction	Section Number	Township Number	Range Number
County: <u>SEDGWICK</u>	<u>NE 1/4 NE 1/4 NE 1/4</u>	<u>16</u>	<u>T 28 S</u>	<u>R 1E E/W</u>

Distance and direction from nearest town or city street address of well if located within city?

4035 No. HydraulicWichita, Ks.

2 WATER WELL OWNER: <u>Randy Belles</u>	Board of Agriculture, Division of Water Resources
RR#, St. Address, Box # : <u>4035 No. Hydraulic</u>	Application Number:
City, State, ZIP Code : <u>Wichita, Kansas</u>	

3 LOCATE WELL'S LOCATION WITH AN "X" IN SECTION BOX:	4 DEPTH OF COMPLETED WELL: <u>.50</u> ft. ELEVATION:
--	--


WELL WATER TO BE USED AS: 5 Public water supply 8 Air conditioning 11 Injection well

1 Domestic 3 Feedlot 6 Oil field water supply 9 Dewatering 12 Other (Specify below)

2 Irrigation 4 Industrial 7 Lawn and garden only 10 Observation well

Was a chemical/bacteriological sample submitted to Department? Yes X No X; If yes, mo/day/yr sample was submittedWater Well Disinfected? Yes X No X

5 TYPE OF BLANK CASING USED:	5 Wrought iron	8 Concrete tile	CASING JOINTS: Glued <u>X</u> Clamped <u>X</u>
1 Steel	3 RMP (SR)	6 Asbestos-Cement	9 Other (specify below)
2 PVC	4 ABS	7 Fiberglass	<u>Cer-Mac styrene SDR-26</u>

Blank casing diameter 5 in. to 25 ft., Dia 5 in. to 25 ft., Dia 5 in. to 25 ft.Casing height above land surface 12 in., weight 1.59 lbs./ft. Wall thickness or gauge No. 203

TYPE OF SCREEN OR PERFORATION MATERIAL:	7 PVC	10 Asbestos-cement
1 Steel	3 Stainless steel	5 Fiberglass
2 Brass	4 Galvanized steel	6 Concrete tile

SCREEN OR PERFORATION OPENINGS ARE: 5 Gauzed wrapped 8 Saw cut 11 None (open hole)

1 Continuous slot 3 Mill slot 6 Wire wrapped 9 Drilled holes

2 Louvered shutter 4 Key punched 7 Torch cut 10 Other (specify)

