


1	LOCATION OF WATER WELL:	Fraction	Section Number	Township Number	Range Number
County:	<i>Sedgwick</i>	<i>NW 1/4 SE 1/4 NE 1/4</i>	<i>16</i>	<i>T 28 S</i>	<i>R 1 E</i>

2 WATER WELL OWNER: Element Smith
RR#, St. Address, Box #: 1615 Georgia
City, State, ZIP Code: Wichita Kansas

3 LOCATE WELL'S LOCATION WITH AN "X" IN SECTION BOX: 4 DEPTH OF COMPLETED WELL: 22 ft. ELEVATION: _____

Depth(s) Groundwater Encountered 1. _____ ft. 2. _____ ft. 3. _____ ft.

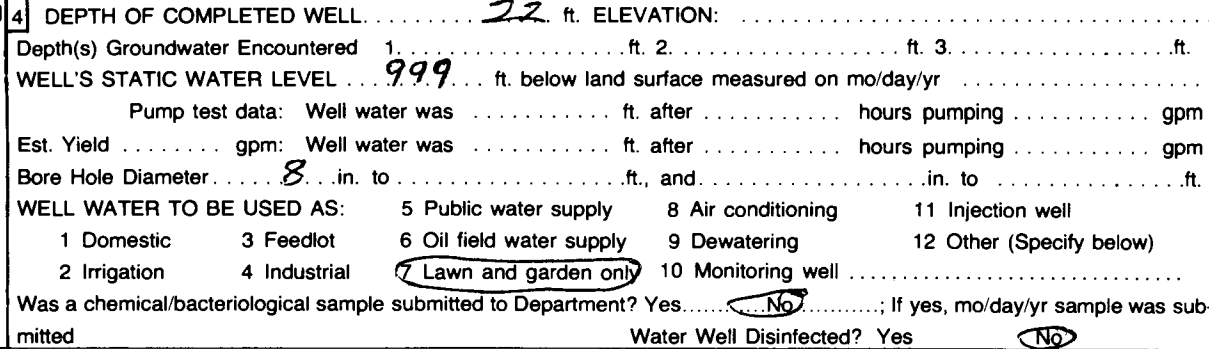

Blank casing diameter 5 in. to ft., Dia in. to ft., Dia in. to ft.
Casing height above land surface 12 in., weight lbs./ft. Wall thickness or gauge No.

SCREEN OR PERFORATION OPENINGS ARE:

1 Continuous slot	3 Mill slot	5 Gauzed wrapped	8 Saw cut	11 None (open hole)
2 Louvered shutter	4 Key punched	6 Wire wrapped	<u>9 Drilled holes</u>	
		7 Torch cut	10 Other (specify)	

SCREEN-PERFORATED INTERVALS:	From	10	ft. to	22	ft., From		ft. to		ft.
	From		ft. to		ft., From		ft. to		ft.
GRAVEL PACK INTERVALS:	From		ft. to		ft., From		ft. to		ft.
	From		ft. to		ft., From		ft. to		ft.

6 GROUT MATERIAL: 1 Neat cement 2 Cement grout 3 Bentonite 4 Other clay
Grout intervals: From 22 ft. to 0 ft., From _____ ft. to _____ ft., From _____ ft. to _____ ft.

What is the nearest source of possible contamination:			10 Livestock pens	14 Abandoned water well
1 Septic tank	4 Lateral lines	7 Pit privy	11 Fuel storage	15 Oil well/Gas well
2 Sewer lines	5 Cess pool	8 Sewage lagoon	12 Fertilizer storage	16 Other (specify below)
3 Watertight sewer lines	6 Seepage pit	9 Feedyard	13 Insecticide storage	<i>None</i>
Direction from well?			How many feet?	

[illegible]

7. CONTRACTOR'S OR LANDOWNER'S CERTIFICATION: This water well was (1) constructed, (2) reconstructed, or (3) plugged under my jurisdiction and was completed on (mo/day/year) 4-16-91 and this record is true to the best of my knowledge and belief. Kansas Water Well Contractor's License No. _____ This Water Well Record was completed on (mo/day/year) 6-4-93 under the business name of _____ by (signature) LeRoy A. Kisley