

1 LOCATION OF WATER WELL:	Fraction	Section Number	Township Number	Range Number
County: <u>SEDGWICK</u>	<u>NE</u> $\frac{1}{4}$ <u>SE</u> $\frac{1}{4}$ <u>SE</u> $\frac{1}{4}$	<u>17</u>	T <u>28</u> S	R <u>1</u> <u>EW</u>


Distance and direction from nearest town or city street address of well if located within city?

2 WATER WELL OWNER: OXY NGL INC
RR#, St. Address, Box #: P.O Box 300
City, State, ZIP Code: TULSA, OKLA 74102

Board of Agriculture, Division of Water Resources
Application Number:

3 LOCATE WELL'S LOCATION WITH AN "X" IN SECTION BOX:

4 DEPTH OF COMPLETED WELL.....49..... ft. ELEVATION: -

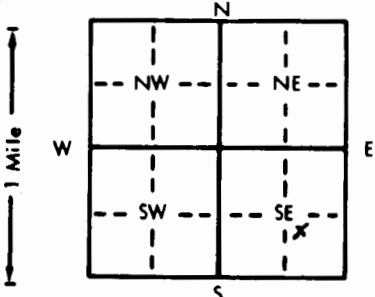

4 DEPTH OF COMPLETED WELL. 49 ft. ELEVATION:

Depth(s) Groundwater Encountered 1. 10.96 ft. 2. ft. 3. ft.

WELL'S STATIC WATER LEVEL 10.96 ft. below land surface measured on mo/day/yr 6/23/89

Pump test data: Well water was ft. after hours pumping gpm

Est. Yield gpm: Well water was ft. after hours pumping gpm

Bore Hole Diameter. 11 in. to 30 ft., and 6 3/4 in. to 49 ft.

WELL WATER TO BE USED AS:

5 Public water supply	8 Air conditioning	11 Injection well		
1 Domestic	3 Feedlot	6 Oil field water supply	9 Dewatering	12 Other (Specify below)
2 Irrigation	4 Industrial	7 Lawn and garden only	10 Monitoring well	

Was a chemical/bacteriological sample submitted to Department? Yes. No. ☒ If yes, mo/day/yr sample was submitted

Water Well Disinfected? Yes. ☒ No. ☐

5 TYPE OF BLANK CASING USED:		3 Wrought iron	8 Concrete tile	CASING JOINTS: Glued . X 8" Clamped
1 Steel	3 RMP (SR)	6 Asbestos-Cement	9 Other (specify below)	Welded
2 PVC	4 ABS	7 Fiberglass		Threaded 2"

Blank casing diameter 8 in. to 30 ft. Dia. 2 in. to 49 ft. Dia. in. to ft.
Casing height above land surface 24 in. weight lbs./ft. Wall thickness or gauge No. SCH 40

TYPE OF SCREEN OR PERFORATION MATERIAL:

1 Steel	3 Stainless steel	5 Fiberglass	7 PVC	10 Asbestos-cement
2 Brass	4 Galvanized steel	6 Concrete tile	8 RMP (SR)	11 Other (specify)
			9 ABS	12 None used (open hole)

SCREEN OR PERFORATION OPENINGS ARE:

1 Continuous slot	3 Mill slot	5 Gauzed wrapped	8 Saw cut	11 None (open hole)
2 Louvered shutter	4 Key punched	6 Wire wrapped	9 Drilled holes	
		7 Torch cut	10 Other (specify)	

SCREEN-PERFORATED INTERVALS:	From	37	ft. to	47	ft. From		ft. to		ft.
	From		ft. to		ft. From		ft. to		ft.
GRAVEL PACK INTERVALS:	From	34	ft. to	49	ft. From		ft. to		ft.
	From		ft. to		ft. From		ft. to		ft.

GROUT MATERIAL: 1 Neat cement 2 Cement grout 3 Bentonite 4 Other

Grout Intervals: From 0 ft. to 3 ft. From ft. to ft. From ft. to ft.

What is the nearest source of possible contamination:

1 Septic tank	4 Lateral lines	7 Pit privy	10 Livestock pens	14 Abandoned water well
2 Sewer lines	5 Cess pool	8 Sewage lagoon	11 Fuel storage	15 Oil well/Gas well
3 Watertight sewer lines	6 Seepage pit	9 Feedyard	12 Fertilizer storage	16 Other (specify below)
			13 Insecticide storage	

Direction from well? _____ How many feet? _____

[illegible]

7 CONTRACTOR'S OR LANDOWNER'S CERTIFICATION: This water well was (1) constructed, (2) reconstructed, or (3) plugged under my jurisdiction and was completed on (mo/day/year) 6/23/89 and this record is true to the best of my knowledge and belief. Kansas Water Well Contractor's License No. 334 This Water Well Record was completed on (mo/day/yr) 10/1/90 under the business name of EWBANK INC by (signature) Jenny Ewbank J Pro.