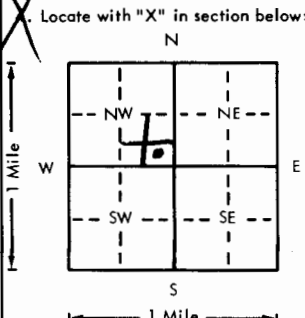


USE TYPEWRITER OR BALL
POINT PEN-PRESS FIRMLY,
PRINT CLEARLY.

WATER WELL RECORD
KSA 82a-1201-1215

Kansas Department of Health and
Environment-Division of Environment
(Water well Contractors)
Topeka, Kansas 66620

1. Location of well:		County Sedgwick	Section number 17	Township number 28	Range number 1 E D W
2. Distance and direction from nearest town or city: Street address of well location if in city: 727 W. MacArthur			3. Owner of well: TWIN LAKES APARTMENTS R.R. or street: 1828 W. 18th City, state, zip code: Wichita KS 67203		
X Locate with "X" in section below: 			Sketch map:		
5. Type and color of material			From	To	6. Bore hole dia. 9 in. Completion date 5-10-79 Well depth 33 ft.
Drk. Brown Sandy/clay loam BACK fill			0	3	7. Cable tool ☐ Rotary ☐ Driven ☐ Dug ☐ Hollow rod ☐ Jetted ☒ Bored ☐ Reverse rotary
LT. BROWN " " "			3	4	8. Use: Domestic ☐ Public supply ☐ Industry ☐ Irrigation ☐ Air conditioning ☐ Stock ☐ ☒ Lawn ☐ Oil field water ☐ Other
" " fine Sand			6	8	9. Casing: Material RMP Height Above below Threaded ☐ Welded ☒ Surface 12 in. RMP ☒ PVC ☐ Weight ☐ lbs./ft. Dia. 4 in. to 0 ft. depth Wall Thickness: inches or Dia. 4 in. to 33 ft. depth gage No. 20
" " med. fine Sand			8	20	10. Screen Manufacturer's name Sunflower Type RMP Dia. 4" Slot/gauze 3/16 Length 5 FT Set between 4-5-28 ft. and 33 ft. Gravel pack? No Size range of material
" " med Course gravel			20	33	11. Static water level: 8 mo./day/yr. ft. below land surface Date 5-8-79
					12. Pumping level below land surfaces: ft. after hrs. pumping g.p.m. ft. after hrs. pumping g.p.m. Estimated maximum yield 40 g.p.m.
					13. Water sample submitted: mo./day/yr. Yes ☒ No ☐ Date
					14. Well head completion: Pitless adapter 12 Inches above grade
					15. Well grouted? yes With: Neat cement ☐ Bentonite ☒ Concrete ☐ Depth: From 0 ft. to 8 ft.
					16. Nearest source of possible contamination: Plastic ft. 12 Direction NW Type sewer Well disinfected upon completion? Yes ☐ No ☒
					17. Pump: ☒ Not installed Manufacturer's name Model number HP Volts Length of drop pipe ft. capacity g.p.m. Type: ☐ Submersible ☐ Turbine ☐ Jet ☐ Reciprocating ☐ Centrifugal ☐ Other
(Use a second sheet if needed)					
18. Elevation: Topography: ☐ Hill ☐ Slope ☐ Upland ☒ Valley	19. Remarks:		20. Water well contractor's certification: This well was drilled under my jurisdiction and this report is true to the best of my knowledge and belief. PROTHEROE PUMP & WELL SERVICE 827 W. 27th ST. S. 522-3729 Business Address: WICHITA, KANSAS 67217 License No. Signed: Protheroe Date: 5-10-79 Authorized representative		

Forward the white, blue and pink copies to the Department of Health and Environment

Form WWC-5