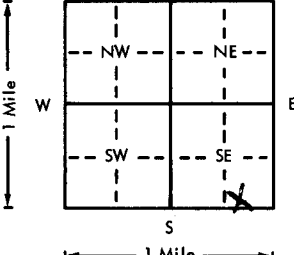
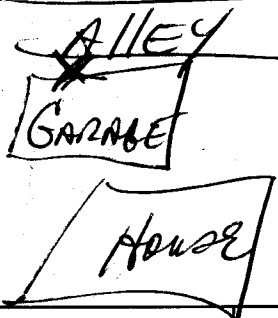


USE TYPEWRITER OR BALL  
POINT PEN-PRESS FIRMLY,  
PRINT CLEARLY.

WATER WELL RECORD  
KSA 82a-1201-1215

Kansas Department of Health and  
Environment-Division of Environment  
(Water well Contractors)  
Topeka, Kansas 66620

|   |  |                                                                                                  |                                         |   |                                  |   |
|---|--|--------------------------------------------------------------------------------------------------|-----------------------------------------|---|----------------------------------|---|
| 1. Location of well:   |  | County<br><u>Sedgwick</u>                                                                        | Fraction<br><u>SW 1/4 SE 1/4 SE 1/4</u> | Section number<br><u>18</u>   | Township number<br><u>T 28 S</u> | Range number<br><u>R 1E E/W</u>   |
| 2. Distance and direction from nearest town or city:<br>Street address of well location if in city: <u>4602 S. Fern</u>   |  |                                                                                                  |                                         | 3. Owner of well: <u>David Mills PAUGH</u><br>R.R. or street: <u>522-5955</u><br>City, state, zip code: <u>Wichita, KS.</u>   |                                  |   |
| 4. Locate with "X" in section below:<br> |  | Sketch map:<br> |                                         | 6. Bore hole dia. <u>11</u> in. Completion date <u>5-2-79</u><br>Well depth <u>27</u> ft.   |                                  |   |
| 5. Type and color of material                                                                                             |  | From                                                                                             |                                         | To   |                                  | 7. <input type="checkbox"/> Cable tool <input type="checkbox"/> Rotary <input type="checkbox"/> Driven <input type="checkbox"/> Dug<br><input type="checkbox"/> Hollow rod <input checked="" type="checkbox"/> Jetted <input type="checkbox"/> Bored <input type="checkbox"/> Reverse rotary   |
|   |  |                                                                                                  |                                         |   |                                  | 8. Use: <input type="checkbox"/> Domestic <input type="checkbox"/> Public supply <input type="checkbox"/> Industry<br><input type="checkbox"/> Irrigation <input type="checkbox"/> Air conditioning <input type="checkbox"/> Stack<br><input checked="" type="checkbox"/> Lawn <input type="checkbox"/> Oil field water <input type="checkbox"/> Other                                                                                                   |
|   |  |                                                                                                  |                                         |   |                                  | 9. Casing: Material <input type="checkbox"/> Height: Above or below<br>Threaded <input type="checkbox"/> Welded <input type="checkbox"/> Surface <u>12</u> in.<br>RMP <input type="checkbox"/> PVC <input checked="" type="checkbox"/> Weight <u>2.758</u> lbs./ft.<br>Dia. <u>5</u> in. to <u>   </u> ft. depth Wall Thickness: inches or<br>Dia. <u>   </u> in. to <u>   </u> ft. depth gage No. <u>258</u>                                            |
|   |  |                                                                                                  |                                         |   |                                  | 10. Screen: Manufacturer's name <u>Modern Pipe Co.</u><br>Type <u>MC</u> Dia. <u>5.563</u><br>Slot/gauze <u>.025</u> Length <u>5</u><br>Set between <u>22</u> ft. and <u>27</u> ft.<br><u>   </u> ft. and <u>   </u> ft.<br>Gravel pack? <u>No</u> Size range of material <u>   </u>   |
|   |  |                                                                                                  |                                         |   |                                  | 11. Static water level: <u>   </u> mo./day/yr.<br><u>17</u> ft. below land surface Date <u>5-2-79</u>   |
|   |  |                                                                                                  |                                         |   |                                  | 12. Pumping level below land surfaces:<br><u>17</u> ft. after <u>1</u> hrs. pumping <u>20</u> g.p.m.<br><u>   </u> ft. after <u>   </u> hrs. pumping <u>   </u> g.p.m.<br>Estimated maximum yield <u>50</u> g.p.m.   |
|   |  |                                                                                                  |                                         |   |                                  | 13. Water sample submitted: <u>   </u> mo./day/yr.<br><input type="checkbox"/> Yes <input checked="" type="checkbox"/> No Date <u>   </u>   |
|   |  |                                                                                                  |                                         |   |                                  | 14. Well head completion:<br><input type="checkbox"/> Pitless adapter <u>12</u> inches above grade   |
|   |  |                                                                                                  |                                         |   |                                  | 15. Well grouted? <u>YES</u><br>With: <input checked="" type="checkbox"/> Neat cement <input type="checkbox"/> Bentonite <input type="checkbox"/> Concrete<br>Depth: From <u>0</u> ft. to <u>10</u> ft.   |
|   |  |                                                                                                  |                                         |   |                                  | 16. Nearest source of possible contamination:<br>ft. <u>50</u> Direction <u>S</u> Type <u>SEWER</u><br>Well disinfected upon completion? <input checked="" type="checkbox"/> Yes <input type="checkbox"/> No   |
|   |  |                                                                                                  |                                         |   |                                  | 17. Pump: <input checked="" type="checkbox"/> Not installed<br>Manufacturer's name <u>   </u><br>Model number <u>   </u> HP <u>   </u> Volts <u>   </u><br>Length of drop pipe <u>   </u> ft. capacity <u>   </u> g.p.m.<br>Type:<br><input type="checkbox"/> Submersible <input type="checkbox"/> Turbine<br><input type="checkbox"/> Jet <input type="checkbox"/> Reciprocating<br><input type="checkbox"/> Centrifugal <input type="checkbox"/> Other |
| 18. Elevation:   |  | 19. Remarks:                                                                                     |                                         | 20. Water well contractor's certification:<br>This well was drilled under my jurisdiction and this report<br>is true to the best of my knowledge and belief.<br><u>2151 E. 1st</u> <u>129</u><br>Business name <u>512 W. 21 / Wichita</u> License No. <u>   </u><br>Address <u>   </u> Date <u>5-30-79</u><br>Signed <u>J. Naube</u> authorized representative |                                  |   |

Forward the white, blue and pink copies to the Department of Health and Environment

Form WWC-5