USE TYPEWRITER OR BALL POINT PEN-PRESS FIRMLY, PRINT CLEARLY.

T R EW sec 1/4 1/4 1/4 No.

WATER WELL RECORD
KSA 82a-1201-1215

Kansas State Dept. Of Health
(Water Well Contractors)
Forbes-Bldg. 740
Topeka, Kansas 66620

1 Location of well:	County	Township name	Fraction	Section number	Town number	Range number
	Sedgwich	Wichita	NE 1/4 SW 1/4 NE 1/4	19	T28S	R1E

Distance and direction from nearest town or city:

Street address of well location if in city: 1501 W 50th So

3 Owner of well: J.W. Allen

Address: 1501 W 50th So Wichita, KS

Locate with "X" in section below:

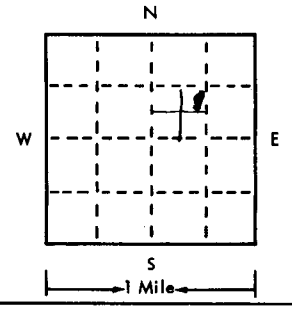

Sketch map: NE 1/4 of the SW 1/4 " " NE 1/4

4 Well depth: 31 ft. Date of completion 4-5-75
Well diameter 10 in. Bore

5 ☐ Cable tool ☐ Rotary ☐ Driven ☐ Dug ☐ Hollow rod ☐ Jetted ☒ Bored ☐ Reverse rotary

6 Use: ☐ Domestic ☐ Public supply ☐ Industry ☒ Irrigation ☐ Air conditioning ☐ Commercial ☐ Test well ☐ ____

7 Casing: Material PVC Height: above/below
Threaded ☐ Welded ☐ Surface 12 in.
Diam. Weight ____ lbs./ft.
10 in. to 0 ft. depth Drive shoe? ☐ Yes ☒ No
10 in. to 31 ft. depth

8 Screen:
Manufacturer Sunflower
Type PVC Dia. 6 11
Slot/gauze 3/16 Length 5 Ft
Set between 26 ft. and 31 ft.
Fittings:
Gravel pack ☐ Yes ☒ No Size range of material ____

2 Type and color of material	From	To
Top Soil Brown	0	3
Fine Sand Light Brown	3	6
Med " " "	6	25
Course gravel Dark "	25	31

9 Static water level:
6 ft. below land surface Date 4-5-75

10 Pumping level below land surfaces:
____ ft. after ____ hrs. pumping ____ g.p.m.
____ ft. after ____ hrs. pumping ____ g.p.m.
Estimated maximum yield 60 g.p.m.

11 Water sample submitted:
☐ Yes ☒ No Date ____

12 Well head completion:
☐ Pitless adapter 12 ☒ Inches above grade

13 Well grouted? ☒ Yes ☐ No
☒ Neat cement ☐ Bentonite ☐ ____
Depth: From 0 ft. to 6 ft.

14 Nearest source of possible contamination:
ft. 60 Direction S. E Type Septic
Well disinfected upon completion? ☒ Yes ☐ No

15 Pump: ☐ Not installed
Manufacturer's name AY McDonald
Model number 10W16 HP 1 Volts 115
Length of drop pipe 29 ft. capacity 40 g.m.p.
Type:
☐ Submersible ☐ Turbine
☐ Jet ☐ Reciprocating
☒ Centrifugal ☐ Other

(use a second sheet if needed)

16 Remarks: elevation

Topography:
☐ Hill
☐ Slope
☐ Upland
☒ Valley
Grade

17 Water well contractor's certification:
This well was drilled under my jurisdiction and this report is true to the best of my knowledge and belief.
Glenn L Brothers 295
Business name License No.
Address 827 W 27 So
Signed Glenn L Brothers Date 4-26-75
Authorized representative

Forward the white, blue and pink copies to the Kansas State Dept. Of Health.

Form WWC-5

677-H