USE TYPEWRITER OR BALL POINT PEN-PRESS FIRMLY, PRINT CLEARLY.

T R EW sec 1/4 1/4 1/4 No.

WATER WELL RECORD
KSA 82a-1201-1215

Kansas State Dept. Of Health
(Water Well Contractors)
Forbes-Bldg. 740
Topeka, Kansas 66620

1 Location of well:	County	Township name	Fraction	Section number	Town number	Range number
	Sedgwick	Riverside	SW¼ SE¼ SW¼	20	28S	1E

Distance and direction from nearest town or city: 501 West 55th S.
Street address of well location if in city: Wichita, Kansas

3 Owner of well: Richard V. Vant Leven
Address: 501 West 55th St. South Wichita, Kansas

Locate with "X" in section below:

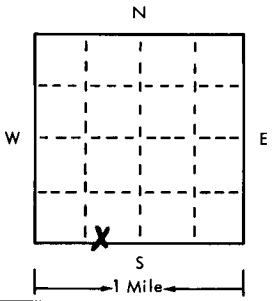

Sketch map:

4 Well depth: 42 ft. Date of completion 4-27-75
Well diameter 11 in.

5 ☐ Cable tool ☒ Rotary ☐ Driven ☐ Dug ☐ Hollow rod ☐ Jetted ☐ Bored ☐ Reverse rotary

6 Use: ☒ Domestic ☐ Public supply ☐ Industry ☐ Irrigation ☐ Air conditioning ☐ Commercial ☐ Test well ☐ _____

7 Casing: Material Styrene Height: above/below
Threaded ☐ Welded ☐ Surface 12 in.
Djam. Weight ____ lbs./ft.
5 in. to 42 ft. depth Drive shoe? ☐ Yes ☐ No
____ in. to ____ ft. depth

2 Type and color of material	From	To
Dirt and Fine Sandy Soil	0	2
Clay	2	8
Coarse Sand	8	42
(use a second sheet if needed)		

8 Screen:
Manufacturer Sunflower Plastics
Type Styrene Dia. 5"
Slot/gauze .005 Length 20
Set between 22 ft. and 42 ft.
Fittings:
Gravel pack ☒ Yes ☐ No Size range of material ¼-1/8"

9 Static water level:
12 ft. below land surface Date 4-27-75

10 Pumping level below land surfaces:
____ ft. after ____ hrs. pumping ____ g.p.m.
____ ft. after ____ hrs. pumping ____ g.p.m.
Estimated maximum yield ____ g.p.m.

11 Water sample submitted:
☐ Yes ☐ No Date ____

12 Well head completion: capped
☐ Pitless adapter 12 ☒ Inches above grade

13 Well grouted? ☒ Yes ☐ No
☒ Neat cement ☐ Bentonite ☐ _____
Depth: From 0 ft. to 10 ft.

14 Nearest source of possible contamination:
ft. 100 Direction SE Type Septic
Well disinfected upon completion? ☒ Yes ☐ No

15 Pump: ☒ Not installed
Manufacturer's name ____
Model number ____ HP ____ Volts ____
Length of drop pipe ____ ft. capacity ____ g.m.p.
Type:
☐ Submersible ☐ Turbine
☐ Jet ☐ Reciprocating
☐ Centrifugal ☐ Other

16 Remarks: elevation
Flat Ground

Topography:
☐ Hill
☐ Slope
☐ Upland
☐ Valley

17 Water well contractor's certification:
This well was drilled under my jurisdiction and this report is true to the best of my knowledge and belief.
Business name Harp Well & Pump License No. 236
Address Wichita, Kansas 67209
Signed M. Arnold Date 5-1-75
Authorized representative

Forward the white, blue and pink copies to the Kansas State Dept. Of Health.

Form WWC-5

677-H