

1	LOCATION OF WATER WELL:	Fraction	Section Number	Township Number	Range Number
	Stedwick	NW NE ¼ NE ¼ NE ¼	23 26	T 28 S	R 1E


Distance and direction from nearest town or city street address of well if located within city?

4653 East 55th Wichita, Ks.

2] WATER WELL OWNER:	Tom Greb	
RR#, St. Address, Box # :	4653 E. 55th So.	Board of Agriculture, Division of Water Resources
City, State, ZIP Code :	Wichita, Ks.	Application Number:

3 LOCATE WELL'S LOCATION WITH AN "X" IN SECTION BOX: 4 DEPTH OF COMPLETED WELL... 65' ft. ELEVATION: ft.

WELL'S STATIC WATER LEVEL ... 25 ... ft. below land surface measured on mo/day/yr ... 7-28-89

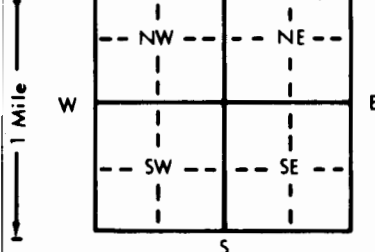

Pump test data: Well water was ft. after hours pumping gpm
Est. Yield gpm: Well water was ft. after hours pumping gpm
Bore Hole Diameter . . . 11 . . . in. to . . . 65 . . . ft., and . . . in. to . . . ft.
WELL WATER TO BE USED AS:
 1 Domestic 3 Feedlot 6 Oil field water supply 9 Dewatering 11 Injection well
 2 Irrigation 4 Industrial 7 Lawn and garden only 10 Monitoring well . . .
Was a chemical/bacteriological sample submitted to Department? Yes.....No....X.....; If yes, mo/day/yr sample was sub-
mitted Water Well Disinfected? Yes X No

5] TYPE OF BLANK CASING USED:		5 Wrought iron	8 Concrete tile	CASING JOINTS: Glued ☒ . . . Clamped . . .	
1 Steel	3 RMP (SR)	6 Asbestos-Cement	9 Other (specify below)	Welded . . .	
2 PVC	4 ABC	7 Fiberglass	Cer-Mac styrene SDR-26	Threaded . . .	
Blank casing diameter 5 . . . in. to . . . 25 . . . ft., Dia		. . . in. to . . . ft., Dia		. . . in. to . . . ft.	
Casing height above land surface 12 . . . in., weight . . . 1.59 . . . lbs./ft.		Wall thickness or gauge No.		.203	

TYPE OF SCREEN OR PERFORATION MATERIAL:			7 PVC	10 Asbestos-cement
1 Steel	3 Stainless steel	5 Fiberglass	8 RMP (SR)	11 Other (specify)
2 Brass	4 Galvanized steel	6 Concrete tile	<u>9 ABS</u>	12 None used (open hole)

SCREEN OR PERFORATION OPENINGS ARE:		5 Gauzed wrapped	8 Saw cut	11 None (open hole)
1 Continuous slot	3 Mill slot	6 Wire wrapped	9 <u>Drilled holes</u>	
2 Louvered shutter	4 Key punched	7 Torch cut	10 Other (specify)	

SCREEN-PERFORATED INTERVALS:	From 25 ft. to 65 ft.,	From ft. to ft.
	From ft. to ft.,	From ft. to ft.
GRAVEL PACK INTERVALS:	From 24 ft. to 65 ft.,	From ft. to ft.
	From ft. to ft.,	From ft. to ft.

6	GROUT MATERIAL:		1 Neat cement	2 Cement grout	3 Bentonite	4 Other								
	Grout Intervals:	From	4	ft. to	24	ft. From		ft. to		ft. From		ft. to		ft.

What is the nearest source of possible contamination:

1 Septic tank	4 Lateral lines	7 Pit privy	10 Livestock pens	14 Abandoned water well
2 <u>Sewer lines</u>	5 Cess pool	8 Sewage lagoon	11 Fuel storage	15 Oil well/Gas well
3 Watertight sewer lines	6 Seepage pit	9 Feedyard	12 Fertilizer storage	16 Other (specify below)
Direction from well? South			13 Insecticide storage	
			How many feet? 85	

Direction from well? South How many feet? 85

[illegible]

7 CONTRACTOR'S OR LANDOWNER'S CERTIFICATION: This water well was (1) constructed, (2) reconstructed, or (3) plugged under my jurisdiction and was completed on (mo/day/year) 7-28-89 and this record is true to the best of my knowledge and belief. Kansas Water Well Contractor's License No. 236 This Water Well Record was completed on (mo/day/yr) 10-15-89 under the business name of Horn Well and Pump Service, Inc. by (signature) Mary Arnold

INSTRUCTIONS: Use typewriter or ball point pen. PLEASE PRESS FIRMLY and PRINT clearly. Please fill in blanks, underline or circle the correct answers. Send three copies to Kansas Department of Health and Environment, Bureau of Water Protection, Topeka, Kansas 66620-7320. Telephone: 913-296-5514. Send one to WATER WELL OWNER and retain one for your records.