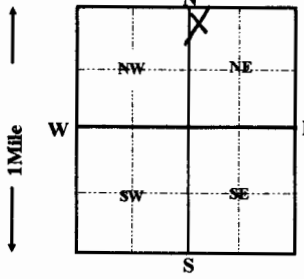


1 LOCATION OF WATER WELL:		FRACTION	Section Number		Township Number	Range Number	
Sedgwick		NW 1/4 NW 1/4 NE 1/4	23		T 28 S	R 1E E/W	
Distance and direction from nearest town or city street address of well if located within city?							
47th S. and K-15 SE Corner Wichita, Kansas							
2 WATER WELL OWNER:		D & M HARDWARE					
RR#, ST. ADDRESS, BOX #:		4810 S.E. Blvd.					
CITY, STATE, ZIP CODE:		Wichita, Kansas					
Board of Agriculture, Division of Water Resource Application Number:							
3 LOCATE WELL'S LOCATION WITH AN "X" IN SECTION BOX:		4 DEPTH OF COMPLETED WELL 50 ft. ELEVATION:					
		Depth(s) groundwater Encountered 1 ft. 2 ft. 3 ft. ft.					
		WELL'S STATIC WATER LEVEL 25 FT. BELOW LAND SURFACE MEASURED ON mo/day/yr 08/06/1992					
		Pump test data: Well water was ft. after hours pumping gpm					
		Est. Yield gpm: Well water was ft. after hours pumping gpm					
		Bore Hole Diameter 12 in. to 50 ft., and in. to ft.					
		WELL WATER TO BE USED AS: 5 Public water supply 8 Air conditioning 11 Injection well					
		1 Domestic 3 Feedlot 6 Oil field water supply 9 Dewatering 12 Other (Specify below)					
		2 Irrigation 4 Industrial 7 Lawn and garden only 10 Monitoring well					
		Was a chemical/bacteriological sample submitted to Department? Yes No X ; If yes, mo/day/yr sample was submitted					
		Water Well Disinfected? Yes X No					
5 TYPE OF CASING USED:		CASING JOINTS: Glued X Clamped					
1 Steel 3 RMP (SR)		Welded					
2 PVC 4 ABS		Threaded					
Blank casing Diameter 5 in. to 30 ft., Dia in. to ft., Dia in. to ft.		SDR-26					
Casing height above land surface 12 in., weight 2.35 lbs./ft.		Wall thickness or gauge No. .214					
TYPE OF SCREEN OR PERFORATION MATERIAL:		7 PVC 10 Asbestos-cement					
1 Steel 3 Stainless Steel		8 RMP (SR) 11 other (specify)					
2 Brass 4 Galvanized steel		9 ABS 12 None used (open hole)					
SCREEN OR PERFORATION OPENING ARE:		5 Gauzed wrapped 8 Saw cut 11 None (open hole)					
1 Continuous slot 3 Mill slot		6 Wire wrapped 9 Drilled holes					
2 Louvered shutter 4 Key punched		7 Torch cut 10 Other (specify)					
SCREEN-PERFORATION INTERVALS: from 30 ft. to 50 ft., From ft. to ft.							
GRAVEL PACK INTERVALS: from 24 ft. to 50 ft., From ft. to ft.							
6 GROUT MATERIAL: 1 Neat cement 2 Cement grout 3 Bentonite 4 Other							
Grout Intervals: From 4 ft. to 24 ft., From ft. to ft., From ft. to ft.							
What is the nearest source of possible contamination:		10 Livestock pens 14 Abandon water well					
1 Septic tank 4 Lateral lines 7 Pit privy 11 Fuel storage 15 Oil well/Gas well		12 Fertilizer storage 16 Other (specify below)					
2 Sewer lines 5 Cess pool 8 Sewage lagoon 13 Insecticide storage							
3 Watertight sewer lines 6 Seepage pit 9 Feedyard							
Direction form well? East How many feet? 68							
FROM	TO	LITHOLOGIC LOG	FROM	TO	PLUGGING INTERVALS		
0	3	topsoil					
3	21	clay					
21	37	fine sand					
37	45	medium sand					
45	50	grey shale					
7 CONTRACTOR'S OR LANDOWNER'S CERTIFICATION: This water well was (1) constructed, (2) reconstructed, or (3) plugged under my jurisdiction and was completed on (mo/day/year) 08/06/1992 and this record is true to the best of my knowledge and belief. Kansas Water Well Contractor's License No. 236 This Water Well Record was completed on (mo/day/yr) 09/24/92 Under the business name of Harp Well & Pump Service, Inc by signature Jane Grederick							