


1 LOCATION OF WATER WELL: County: **SEDGWICK** Fraction: **NE 1/4 NW 1/4 NW 1/4** Section Number: **23** Township Number: **T 28 S** Range Number: **R 1 E/W**

Distance and direction from nearest town or city street address of well if located within city?  
**APPOX-3600 E 47 TH ST - WICHITA**

2 WATER WELL OWNER: **KIRTLEY'S TIRE & AUTO WICHITA KS**  
 RR#, St. Address, Box # **POOR BOY TIRE 3600 E 47TH ST WICHITA KS 67210** Board of Agriculture, Division of Water Resources  
 City, State, ZIP Code Application Number:

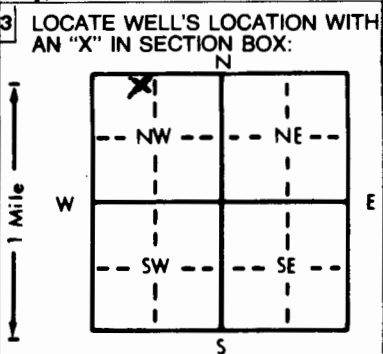

4 DEPTH OF COMPLETED WELL: **22** ft. ELEVATION:  
 Depth(s) Groundwater Encountered 1. **13.5** ft. 2. — ft. 3. — ft.  
 WELL'S STATIC WATER LEVEL **11.29** ft. below land surface measured on mo/day/yr **12-21-93**  
 Pump test data: Well water was — ft. after — hours pumping — gpm  
 Est. Yield — gpm: Well water was — ft. after — hours pumping — gpm  
 Bore Hole Diameter **7.25** in. to **22** ft. and — in. to — ft.  
 WELL WATER TO BE USED AS: 5 Public water supply 8 Air conditioning 11 Injection well  
 1 Domestic 3 Feedlot 6 Oil field water supply 9 Dewatering 12 Other (Specify below)  
 2 Irrigation 4 Industrial 7 Lawn and garden only 10 Monitoring well  
 Was a chemical/bacteriological sample submitted to Department? Yes — No **X**; If yes, mo/day/yr sample was submitted  
 Water Well Disinfected? Yes — No **X**

5 TYPE OF BLANK CASING USED: 5 Wrought iron 8 Concrete tile CASING JOINTS: Glued — Clamped —  
 1 Steel 3 RMP (SR) 6 Asbestos-Cement 9 Other (specify below) Welded —  
 2 PVC 4 ABS 7 Fiberglass Threaded **X**  
 Blank casing diameter **2** in. to **10** ft., Dia. — in. to — ft., Dia. — in. to — ft.  
 Casing height above land surface **FLUSH MOUNT**, weight **SCH 40** lbs./ft. Wall thickness or gauge No. —  
 TYPE OF SCREEN OR PERFORATION MATERIAL: 7 PVC 10 Asbestos-cement  
 1 Steel 3 Stainless steel 5 Fiberglass 8 RMP (SR) 11 Other (specify) —  
 2 Brass 4 Galvanized steel 6 Concrete tile 9 ABS 12 None used (open hole)  
 SCREEN OR PERFORATION OPENINGS ARE: 5 Gauzed wrapped 8 Saw cut 11 None (open hole)  
 1 Continuous slot 3 Mill slot 6 Wire wrapped 9 Drilled holes  
 2 Louvered shutter 4 Key punched 7 Torch cut 10 Other (specify) —  
 SCREEN-PERFORATED INTERVALS: From **10** ft. to **20** ft., From — ft. to — ft.  
**SAND** From — ft. to — ft., From — ft. to — ft.  
~~GRAVEL~~ PACK INTERVALS: From **9** ft. to **22** ft., From — ft. to — ft.  
 From — ft. to — ft., From — ft. to — ft.

6 GROUT MATERIAL: 1 Neat cement 2 Cement grout 3 Bentonite 4 Other —  
 Grout Intervals: From **2** ft. to **7** ft., From **7** ft. to **9** ft., From — ft. to — ft.  
 What is the nearest source of possible contamination:  
 1 Septic tank 4 Lateral lines 7 Pit privy 10 Livestock pens 14 Abandoned water well  
 2 Sewer lines 5 Cess pool 8 Sewage lagoon 11 Fuel storage 15 Oil well/Gas well  
 3 Watertight sewer lines 6 Seepage pit 9 Feedyard 12 Fertilizer storage 16 Other (specify below) **\* CONTAMINATED SITE**  
 13 Insecticide storage  
 Direction from well? — How many feet? —

FROM	TO	LITHOLOGIC LOG	FROM	TO	PLUGGING INTERVALS
<b>GL</b>	<b>1</b>	<b>SOIL - CLAY SILT</b>			<b>* OTHERS UP GRADE OF WATER FLOW - DUMP &amp; BOILING</b>
<b>1</b>	<b>5</b>	<b>SILTY CLAY TO CLAY SILT</b>			
<b>5</b>	<b>8</b>	<b>SAND - TAN</b>			
<b>8</b>	<b>7</b>	<b>SAND WITH CLAY</b>			
<b>9</b>	<b>18.5</b>	<b>CLAY</b>			
<b>13.8</b>	<b>22</b>	<b>SAND</b>			
<b>22</b>	<b>TD</b>				

7 CONTRACTOR'S OR LANDOWNER'S CERTIFICATION: This water well was (1) constructed, (2) reconstructed, or (3) plugged under my jurisdiction and was completed on (mo/day/year) **12-16-93** and this record is true to the best of my knowledge and belief. Kansas Water Well Contractor's License No. **479** This Water Well Record was completed on (mo/day/yr) **12-22-93** under the business name of **EBBERTS DRILLING** by (signature) *Deagan Ebberts*