USE TYPEWRITER OR BALL POINT PEN-PRESS FIRMLY, PRINT CLEARLY.

T R EW sec 1/4 1/4 1/4 No.

WATER WELL RECORD
KSA 82a-1201-1215

Kansas State Dept. Of Health
(Water Well Contractors)
Forbes-Bldg. 740
Topeka, Kansas 66620

1 Location of well:	County	Township name	Fraction	Section number	Town number	Range number
	Sedgwick	Riverside	SE 1/4 of the NW 1/4 " " SW 1/4 " "	27	T28S	R1E

Distance and direction from nearest town or city: 1/2 mile South Wichita KS
Street address of well location if in city: 6114 minneapolis

3 Owner of well: F W Slusser
Address: 6114 minneapolis

Locate with "X" in section below:

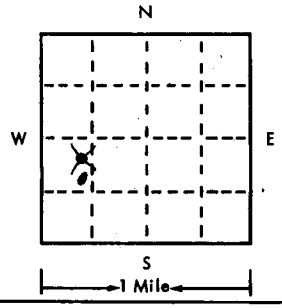

Sketch map:
SE 1/4 of the
NW 1/4 " "
SW 1/4

4 Well depth: 14 ft. Date of completion 5-23-75
Well diameter 7 in. Bore Hole

5 ☐ Cable tool ☐ Rotary ☒ Driven ☐ Dug
☐ Hollow rod ☐ Jetted ☐ Bored ☐ Reverse rotary

6 Use: ☒ Domestic ☐ Public supply ☐ Industry
☐ Irrigation ☐ Air conditioning ☐ Commercial
☐ Test well ☐ _____

7 Casing: Material Iron Height: above/below
Threaded ☒ Welded ☐ Surface 12 in.
Dia. 14 in. to 0 ft. depth Weight _____ lbs./ft.
14 in. to 14 ft. depth Drive shoe? ☐ Yes ☒ No

2 Type and color of material	From	To
Fine Sand light Brown	0	3

(use a second sheet if needed)

8 Screen:
Manufacturer Midwest, Sand Point
Type Sand Pt. Dia. 1 1/4
Slot/gauze 100 Length 4
Set between 10 ft. and 14 ft.
Fittings:
Gravel pack ☐ Yes ☒ No Size range of material _____

9 Static water level:
3 ft. below land surface Date 5-23-75

10 Pumping level below land surfaces:
_____ ft. after _____ hrs. pumping _____ g.p.m.
_____ ft. after _____ hrs. pumping _____ g.p.m.
Estimated maximum yield _____ g.p.m.

11 Water sample submitted:
☐ Yes ☒ No Date _____

12 Well head completion:
☐ Pitless adapter 12 ☒ Inches above grade

13 Well grouted? ☒ Yes ☐ No
☒ Neat cement ☐ Bentonite ☐ _____
Depth: From 0 ft. to 3 ft.

14 Nearest source of possible contamination:
ft. 75 Direction SE Type Septic
Well disinfected upon completion? ☒ Yes ☐ No

15 Pump: ☐ Not installed
Manufacturer's name F & W
Model number C835 HP 1/2 Volts 115
Length of drop pipe 14 ft. capacity 14 g.m.p.
Type:
☐ Submersible ☐ Turbine
☒ Jet ☐ Reciprocating
☐ Centrifugal ☐ Other

16 Remarks: elevation
Water level only 3' Below Basement floor

Tapography:
☐ Hill
☐ Slope
☐ Upland
☒ Valley

17 Water well contractor's certification:
This well was drilled under my jurisdiction and this report is true to the best of my knowledge and belief. 295
Protheroe Pump & Well
Business name License No.
Address 521 W 27th South
Signed [illegible] Date 5-23-75
Authorized representative

Forward the white, blue and pink copies to the Kansas State Dept. Of Health.

Form WWC-5

677-H