SE NE SE NW WATER WELL RECORD Form WWC-5 KSA 82a-1212

1 LOCATION OF WATER WELL: County: SEDGWICK | Fraction: SE ¼ SE ¼ NW ¼ | Section Number: 28 | Township Number: T 28 S | Range Number: R 1 (E)W

Distance and direction from nearest town or city street address of well if located within city? SAME AS BELOW

2 WATER WELL OWNER: BUD WADE
RR#, St. Address, Box # : 920 E 58th S.
City, State, ZIP Code : WICH. KS. 67217
Board of Agriculture, Division of Water Resources
Application Number:

3 LOCATE WELL'S LOCATION WITH AN "X" IN SECTION BOX:

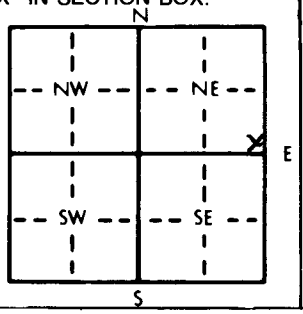


4 DEPTH OF COMPLETED WELL 30 ft. ELEVATION: 1150
Depth(s) Groundwater Encountered 1 12 ft. 2 ft. 3 ft.
WELL'S STATIC WATER LEVEL 12 ft. below land surface measured on mo/day/yr 5-17-91
Pump test data: Well water was 12 ft. after 3 hours pumping 15 gpm
Est. Yield 25 gpm: Well water was ft. after hours pumping gpm
Bore Hole Diameter 10 in. to 30 ft., and in. to ft.
WELL WATER TO BE USED AS: 5 Public water supply 8 Air conditioning 11 Injection well
(1) Domestic 3 Feedlot 6 Oil field water supply 9 Dewatering 12 Other (Specify below)
2 Irrigation 4 Industrial 7 Lawn and garden only 10 Monitoring well
Was a chemical/bacteriological sample submitted to Department? Yes No ✓; If yes, mo/day/yr sample was submitted
Water Well Disinfected? Yes ✓ No

5 TYPE OF BLANK CASING USED: 5 Wrought iron 8 Concrete tile CASING JOINTS: Glued ✓ Clamped
1 Steel 3 RMP (SR) 6 Asbestos-Cement 9 Other (specify below) Welded
(2) PVC 4 ABS 7 Fiberglass Threaded
Blank casing diameter 5 in. to 24 ft., Dia in. to ft., Dia in. to ft.
Casing height above land surface 12 in., weight 2.6 lbs./ft. Wall thickness or gauge No. SDR 26
TYPE OF SCREEN OR PERFORATION MATERIAL: (7) PVC 10 Asbestos-cement
1 Steel 3 Stainless steel 5 Fiberglass 8 RMP (SR) 11 Other (specify)
2 Brass 4 Galvanized steel 6 Concrete tile 9 ABS 12 None used (open hole)
SCREEN OR PERFORATION OPENINGS ARE: 5 Gauzed wrapped 8 Saw cut 11 None (open hole)
1 Continuous slot (3) Mill slot 6 Wire wrapped 9 Drilled holes
2 Louvered shutter 4 Key punched 7 Torch cut 10 Other (specify)
SCREEN-PERFORATED INTERVALS: From 24 ft. to 30 ft., From ft. to ft.
From ft. to ft., From ft. to ft.
GRAVEL PACK INTERVALS: From 12 ft. to 30 ft., From ft. to ft.
From ft. to ft., From ft. to ft.

6 GROUT MATERIAL: 1 Neat cement (2) Cement grout 3 Bentonite 4 Other
Grout Intervals: From 2 ft. to 12 ft., From ft. to ft., From ft. to ft.
What is the nearest source of possible contamination:
1 Septic tank 4 Lateral lines 7 Pit privy 10 Livestock pens 14 Abandoned water well
2 Sewer lines 5 Cess pool 8 Sewage lagoon 11 Fuel storage 15 Oil well/Gas well
3 Watertight sewer lines 6 Seepage pit 9 Feedyard 12 Fertilizer storage 16 Other (specify below)
13 Insecticide storage ROAD
Direction from well? How many feet? 25' 50

| FROM | TO | LITHOLOGIC LOG | FROM | TO | PLUGGING INTERVALS |
|---|---|---|---|---|---|
| 0 | 2 | TOPSOIL | | | |
| 2 | 10 | FINE SAND | | | |
| 10 | 18 | MEDIUM SAND | | | |
| 18 | 30 | COARSE SAND | | | |

7 CONTRACTOR'S OR LANDOWNER'S CERTIFICATION: This water well was (1) constructed, (2) reconstructed, or (3) plugged under my jurisdiction and was completed on (mo/day/year) 5-17-91 and this record is true to the best of my knowledge and belief. Kansas Water Well Contractor's License No. 463 This Water Well Record was completed on (mo/day/yr) 6-17-91 under the business name of R & A by (signature) Dave Rinehart

INSTRUCTIONS: Use typewriter or ball point pen. *PLEASE PRESS FIRMLY* and *PRINT* clearly. Please fill in blanks, underline or circle the correct answers. Send top three copies to Kansas Department of Health and Environment, Bureau of Water, Topeka, Kansas 66620-0001. Telephone: 913-296-5545. Send one to WATER WELL OWNER and retain one for your records.

OFFICE USE ONLY T R E/W SEC. ¼ ¼ ¼