


1 LOCATION OF WATER WELL: County: **SEDGWICK** Fraction: **3/4** **3/4** **1/4** **1/4** Section Number: **28** Township Number: **T 28 S** Range Number: **R 1 E**

Distance and direction from nearest town or city street address of well if located within city?  
**6124 GREENWOOD WICHITA KS 67216**

2 WATER WELL OWNER: **D.O. REITER**  
 RR#, St. Address, Box #: **6124 GREENWOOD** Board of Agriculture, Division of Water Resources  
 City, State, ZIP Code: **WICHITA KS 67216** Application Number:

3 LOCATE WELL'S LOCATION WITH AN "X" IN SECTION BOX:

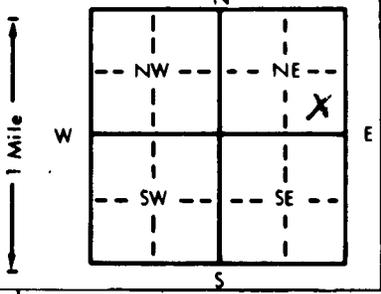

4 DEPTH OF COMPLETED WELL: **32** ft. ELEVATION:  
 Depth(s) Groundwater Encountered 1. **18** ft. 2. **18** ft. 3. **18** ft.  
 WELL'S STATIC WATER LEVEL: **18** ft. below land surface measured on mo/day/yr **6-26-88**  
 Pump test data: Well water was **18** ft. after **2** hours pumping **48** gpm  
 Est. Yield: **60** gpm; Well water was **18** ft. after **2** hours pumping **48** gpm  
 Bore Hole Diameter: **11** in. to **32** ft., and **11** in. to **32** ft.  
 WELL WATER TO BE USED AS:  
 1 Domestic  3 Feedlot  6 Oil field water supply  9 Dewatering  12 Other (Specify below)  
 2 Irrigation  4 Industrial  7 Lawn and garden only  10 Observation well  
 Was a chemical/bacteriological sample submitted to Department? Yes  No   
 Water Well Disinfected? Yes  No

5 TYPE OF BLANK CASING USED:  
 1 Steel  3 RMP (SR)  5 Wrought iron  8 Concrete tile CASING JOINTS: Glued  Clamped   
 2 PVC  4 ABS  6 Asbestos-Cement  9 Other (specify below) Welded   
 7 Fiberglass  Threaded

Blank casing diameter: **5** in. to **22** ft., Dia. **2.37** in. to **250** lbs./ft. Wall thickness or gauge No. **250**  
 Casing height above land surface: **18** in., weight **2.37** lbs./ft.

TYPE OF SCREEN OR PERFORATION MATERIAL:  
 1 Steel  3 Stainless steel  5 Fiberglass  8 RMP (SR)  11 Other (specify)  
 2 Brass  4 Galvanized steel  6 Concrete tile  9 ABS  12 None used (open hole)

SCREEN OR PERFORATION OPENINGS ARE:  
 1 Continuous slot  3 Mill slot  5 Gauzed wrapped  8 Saw cut  11 None (open hole)  
 2 Louvered shutter  4 Key punched  6 Wire wrapped  9 Drilled holes  
 7 Torch cut  10 Other (specify)

SCREEN-PERFORATED INTERVALS: From **22** ft. to **32** ft., From **32** ft. to **32** ft.  
 GRAVEL PACK INTERVALS: From **20** ft. to **32** ft., From **32** ft. to **32** ft.

6 GROUT MATERIAL:  1 Neat cement  2 Cement grout  3 Bentonite  4 Other **0-3' SURFACE SOIL**  
 Grout Intervals: From **3** ft. to **20** ft., From **20** ft. to **32** ft., From **32** ft. to **32** ft.

What is the nearest source of possible contamination:  
 1 Septic tank  4 Lateral lines  7 Pit privy  10 Livestock pens  14 Abandoned water well  
 2 Sewer lines  5 Cess pool  8 Sewage lagoon  11 Fuel storage  15 Oil well/Gas well  
 3 Watertight sewer lines  6 Seepage pit  9 Feedyard  12 Fertilizer storage  16 Other (specify below)  
 13 Insecticide storage  
 Direction from well? **EAST** How many feet? **60**

FROM	TO	LITHOLOGIC LOG	FROM	TO	LITHOLOGIC LOG
0	4	SANDY LOAM TOP SOIL			
4	8	SILT			
8	13	CLAY			
13	18	FINE SAND			
18	32	COURSE SAND, SMALL GRAVEL			

7 CONTRACTOR'S OR LANDOWNER'S CERTIFICATION: This water well was  (1) constructed,  (2) reconstructed, or  (3) plugged under my jurisdiction and was completed on (mo/day/year) **6-26-88** and this record is true to the best of my knowledge and belief. Kansas Water Well Contractor's License No. **437** This Water Well Record was completed on (mo/day/yr) **7-12-88**  
 under the business name of **TALPA METZGER WELL DIGGER** by **Talpa Metzger**

INSTRUCTIONS: Use typewriter or ball point pen. PLEASE PRESS FIRMLY and PRINT clearly. Please fill in blanks, underline or circle the correct answers. Send top three copies to Kansas Department of Health and Environment, Bureau of Water Protection, Topeka, Kansas 66620-7320, Telephone: 913-862-9360. Send one to WATER WELL OWNER and retain one for your records.