

1 LOCATION OF WATER WELL: County: <u>SEDGWICK</u>	Fraction <u>NW 1/4 SE 1/4 SE 1/4</u>	Section Number <u>30</u>	Township Number T <u>28</u> S	Range Number R <u>1</u> EW
--	---	-----------------------------	----------------------------------	-------------------------------

Distance and direction from nearest town or city street address of well if located within city?


1300 W 63 ST South

2 WATER WELL OWNER: STEVE BLAIR
 RR#, St. Address, Box #: 1300 W 31 ST South
 City, State, ZIP Code: Wichita Kansas 67217

Board of Agriculture, Division of Water Resources

Application Number:

3 LOCATE WELL'S LOCATION WITH
 AN "X" IN SECTION BOX:

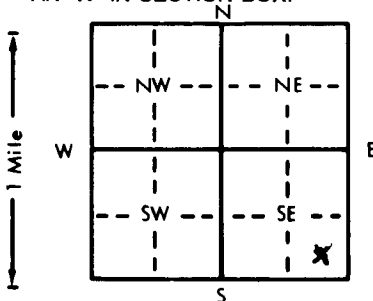

4 DEPTH OF COMPLETED WELL: 28 ft. ELEVATION:

Depth(s) Groundwater Encountered 1. 14 ft. 2. 10-10-83 ft. 3. 50 ft.

WELL'S STATIC WATER LEVEL 14 ft. below land surface measured on mo/day/yr 10-10-83

Pump test data: Well water was 16 ft. after 2 hours pumping 50 gpm

Est. Yield 75 gpm Well water was 14 ft. after 5 hours pumping 28 gpm

Bore Hole Diameter 9 in. to 14 ft., and 5.5 in. to 28 ft.

WELL WATER TO BE USED AS: 5 Public water supply 8 Air conditioning 11 Injection well

1 Domestic 3 Feedlot 6 Oil field water supply 9 Dewatering 12 Other (Specify below)

2 Irrigation 4 Industrial 7 Lawn and garden only 10 Observation well

Was a chemical/bacteriological sample submitted to Department? Yes Yes No No If yes, mo/day/yr sample was submitted

Water Well Disinfected? Yes No

5 TYPE OF BLANK CASING USED:

1 Steel 3 RMP (SR)

2 PVC 4 ABS

Blank casing diameter 5 in. to 14 ft., Dia. 14 in. to 28 ft., Dia. 28 in. to 28 ft.

Casing height above land surface 12 in., weight 237 lbs./ft. Wall thickness or gauge No. 250

TYPE OF SCREEN OR PERFORATION MATERIAL:

1 Steel 3 Stainless steel

2 Brass 4 Galvanized steel

SCREEN OR PERFORATION OPENINGS ARE:

1 Continuous slot 3 Mill slot

2 Louvered shutter 4 Key punched



6 GROUT MATERIAL:


What is the nearest source of possible contamination:

1 Septic tank 4 Lateral lines 7 Pit privy 10 Livestock pens 14 Abandoned water well

2 Sewer lines 5 Cess pool 8 Sewage lagoon 11 Fuel storage 15 Oil well/Gas well

3 Watertight sewer lines 6 Seepage pit 9 Feedyard 12 Fertilizer storage 16 Other (specify below)

Direction from well? East How many feet? 75

FROM	TO	LITHOLOGIC LOG	FROM	TO	LITHOLOGIC LOG
0	6	Basement			
6	8	CLAY			
8	10	FINE SAND			
10	14	CLAY			
14	28	COURSE SAND + GRAVEL			

7 CONTRACTOR'S OR LANDOWNER'S CERTIFICATION: This water well was (1) constructed, (2) reconstructed, or (3) plugged under my jurisdiction and was completed on (mo/day/year) 10-10-83 and this record is true to the best of my knowledge and belief. Kansas Water Well Contractor's License No. 437 This Water Well Record was completed on (mo/day/year) 10-10-83 under the business name of RALPH METZGER WELL DIGGING DRILLING (signature) Ralph Metzger

INSTRUCTIONS: Use typewriter or ball point pen, PLEASE PRESS FIRMLY and PRINT clearly. Please fill in blanks, underline or circle the correct answers. Send top three copies to Kansas Department of Health and Environment, Division of Environment, Environmental Geology Section, Topeka, KS 66620. Send one to WATER WELL OWNER and retain one for your records.

OFFICE USE ONLY

T

R

EW

SEC

NW 1/4

SE 1/4

SW 1/4

NE 1/4