

1 LOCATION OF WATER WELL:	Fraction	Section Number	Township Number	Range Number
County: <u>SEDGWICK</u>	<u>NW</u> $\frac{1}{4}$ <u>SW</u> $\frac{1}{4}$ <u>NE</u> $\frac{1}{4}$	<u>31</u>	T <u>28</u> S	R <u>1</u> <u>EW</u>

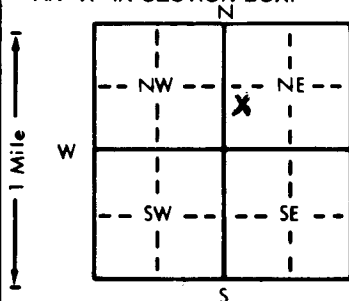
Distance and direction from nearest town or city street address of well if located within city?

411 IVAH HAYSVILLE, KS 670602 WATER WELL OWNER: ROBERT HOFFMANRR#, St. Address, Box #: 411 IVAH ST
City, State, ZIP Code: HAYSVILLE, KANSAS 67060

Board of Agriculture, Division of Water Resources

Application Number:

3 LOCATE WELL'S LOCATION WITH AN "X" IN SECTION BOX:

4 DEPTH OF COMPLETED WELL: 39 ft. ELEVATION:Depth(s) Groundwater Encountered 1. 14 ft. 2. 14 ft. 3. 14 ft.WELL'S STATIC WATER LEVEL 14 ft. below land surface measured on mo/day/yr 5-2-85Pump test data: Well water was 14 ft. after 2 hours pumping 40 gpmEst. Yield 60 gpm Well water was 14 ft. after 2 hours pumping 40 gpmBore Hole Diameter 9 in. to 39 ft., and 39 ft. to 40 ft.

WELL WATER TO BE USED AS: 5 Public water supply 8 Air conditioning 11 Injection well

1 Domestic 3 Feedlot 6 Oil field water supply 9 Dewatering 12 Other (Specify below)

2 Irrigation 4 Industrial 7 Lawn and garden only 10 Observation wellWas a chemical/bacteriological sample submitted to Department? Yes No If yes, mo/day/yr sample was submittedWater Well Disinfected? Yes No

5 TYPE OF BLANK CASING USED:

5 Wrought iron

8 Concrete tile

CASING JOINTS Glued Clamped

1 Steel

3 RMP (SR)

6 Asbestos-Cement

9 Other (specify below)

Welded

2 PVC

4 ABS

7 Fiberglass

Threaded

Blank casing diameter 5 in. to 19 ft., Dia 14 in. to 2.37 in. to 250 ft.Casing height above land surface 14 in., weight 2.37 lbs./ft. Wall thickness or gauge No. 250

TYPE OF SCREEN OR PERFORATION MATERIAL:

1 Steel

3 Stainless steel

5 Fiberglass

8 RMP (SR)

11 Other (specify)

2 Brass

4 Galvanized steel

6 Concrete tile

9 ABS

12 None used (open hole)

SCREEN OR PERFORATION OPENINGS ARE:

1 Continuous slot

3 Mill slot

5 Gauzed wrapped

8 Saw cut

11 None (open hole)

2 Louvered shutter

4 Key punched

6 Wire wrapped

9 Drilled holes

SCREEN-PERFORATED INTERVALS:

From 19 ft. to 39 ft., From 19 ft. to 39 ft.From 13 ft. to 39 ft., From 13 ft. to 39 ft.GRAVEL PACK INTERVALS: From 13 ft. to 39 ft., From 13 ft. to 39 ft.From 13 ft. to 39 ft., From 13 ft. to 39 ft.

6 GROUT MATERIAL:

1 Neat cement

2 Cement grout

3 Bentonite

4 Other 0-3' SURFACE SOILGrout Intervals: From 3 ft. to 13 ft., From 3 ft. to 13 ft.

What is the nearest source of possible contamination:

1 Septic tank

4 Lateral lines

7 Pit privy

10 Livestock pens

14 Abandoned water well

2 Sewer lines

5 Cess pool

8 Sewage lagoon

11 Fuel storage

15 Oil well/Gas well

3 Watertight sewer lines

6 Seepage pit

9 Feedyard

12 Fertilizer storage

16 Other (specify below)

13 Insecticide storage

Direction from well? NORTHHow many feet? 35

FROM	TO	LITHOLOGIC LOG	FROM	TO	LITHOLOGIC LOG
<u>0</u>	<u>4</u>	<u>SURFACE SOIL</u>			
<u>4</u>	<u>14</u>	<u>CLAY</u>			
<u>14</u>	<u>20</u>	<u>FINE SAND</u>			
<u>20</u>	<u>37</u>	<u>COURSE SAND, SMALL GRAVEL</u>			
<u>37</u>	<u>39</u>	<u>CLAY CLAY</u>			

7 CONTRACTOR'S OR LANDOWNER'S CERTIFICATION: This water well was (1) constructed, (2) reconstructed, or (3) plugged under my jurisdiction and wascompleted on (mo/day/year) 5-2-85 and this record is true to the best of my knowledge and belief. KansasWater Well Contractor's License No. 437 This Water Well Record was completed on (mo/day/yr) 5-14-85under the business name of RALPH THIERZ CIVIL WELL DRILLING Ralph L. Thierz

INSTRUCTIONS: Use typewriter or ball point pen, PLEASE PRESS FIRMLY and PRINT clearly. Please fill in blanks, underline or circle the correct answers. Send top

three copies to Kansas Department of Health and Environment, Division of Environment, Environmental Geology Section, Topeka, KS 66620. Send one to WATER WELL

OWNER and retain one for your records.