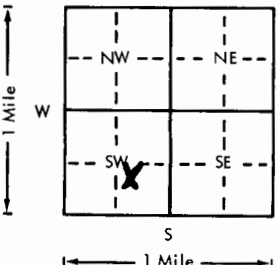
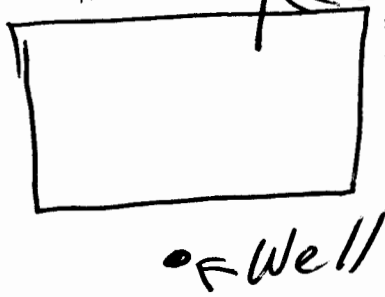


USE TYPEWRITER OR BALL
POINT PEN-PRESS FIRMLY,
PRINT CLEARLY.

WATER WELL RECORD
KSA 82a-1201-1215

Kansas Department of Health and
Environment-Division of Environment
(Water well Contractors)
Topeka, Kansas 66620

1. Location of well:		County <u>Sedgwick</u>	Fraction <u>NW 1/4 SE 1/4 SW 1/4</u>	Section number <u>31</u>	Township number <u>T 28 S R 1 E</u>	Range number <u>1</u>
2. Distance and direction from nearest town or city: Street address of well location if in city: <u>4444 Timberlane Haysville Ks</u>				3. Owner of well: <u>Alexander Const.</u> R.R. or street: <u>1909 Leonine</u> City, state, zip code: <u>Wichita Ks 67213</u>		
4. Locate with "X" in section below:		Sketch map:		6. Bore hole dia. <u>5 1/2</u> in. Completion date <u>5/22/78</u> Well depth <u>50</u> ft.		
				7. ☐ Cable tool ☒ Rotary ☐ Driven ☐ Dug ☐ Hollow rod ☐ Jetted ☐ Bored ☐ Reverse rotary		
5. Type and color of material				8. Use: ☐ Domestic ☐ Public supply ☐ Industry ☐ Irrigation ☐ Air conditioning ☐ Stock ☒ Lawn ☐ Oil field water ☐ Other		
				9. Casing: Material <u>Steel</u> Height: <u>0</u> or below Threaded ☐ Welded ☒ Surface <u>12</u> in. RMP ☒ PVC ☐ Weight <u>11.50</u> lbs./ft. Dia. <u>5</u> in. to <u>50</u> ft. depth Wall Thickness: inches or Dia. <u>5</u> in. to <u>50</u> ft. depth gauge No. <u>1200</u>		
				10. Screen: Manufacturer's name <u>Sunflower</u> Type <u>200</u> Dia. <u>5 in</u> Slot/gauze <u>1/16</u> Length <u>12 ft</u> Set between <u>38</u> ft. and <u>500</u> ft. Gravel pack <u>yes</u> Size range of material <u>3/8</u>		
				11. Static water level: <u>29</u> ft. below land surface Date <u>5/22/78</u> 12. Pumping level below land surfaces: <u>30</u> ft. after <u>1/2</u> hrs. pumping <u>15</u> g.p.m. <u>30</u> ft. after <u>1</u> hrs. pumping <u>15</u> g.p.m. Estimated maximum yield <u>30-50</u> g.p.m.		
				13. Water sample submitted: <u>no./day/yr.</u> ☐ Yes ☒ No Date <u>5/22/78</u>		
				14. Well head completion: ☐ Pitless adapter <u>12</u> inches above grade		
				15. Well grouted? <u>yes</u> With: ☐ Neat cement ☐ Bentonite ☒ Concrete Depth: From <u>3</u> ft. to <u>13</u> ft.		
				16. Nearest source of potable water: <u>City Water</u> ft. <u>50</u> Direction <u>East</u> Well disinfected upon completion? ☒ Yes ☐ No		
				17. Pump: ☒ Not installed Manufacturer's name <u>Wenger</u> Model number <u>318</u> HP <u>1/4</u> Volts <u>115</u> Length of drop pipe <u>50</u> ft. capacity <u>1/4</u> g.p.m. Type: ☐ Submersible ☐ Turbine ☐ Jet ☐ Reciprocating ☐ Centrifugal ☐ Other		

Forward the white, blue and pink copies to the Department of Health and Environment

Form WWC-5