WATER WELL RECORD Form WWC-5 KSA 82a-1212

1 LOCATION OF WATER WELL: County: STEPGWICK | Fraction: NW ¼ SE ¼ SW ¼ | Section Number: 31 | Township Number: T 28 S | Range Number: R 1 (E) W

Distance and direction from nearest town or city street address of well if located within city? 326 PEACH TREE LANE HAYSVILLE KANSAS 67060

2 WATER WELL OWNER: CARROLL WILLIAMS
RR#, St. Address, Box # : 326 PEACH TREE LANE
City, State, ZIP Code : HAYSVILLE KANSAS 67060

Board of Agriculture, Division of Water Resources
Application Number:

3 LOCATE WELL'S LOCATION WITH AN "X" IN SECTION BOX:

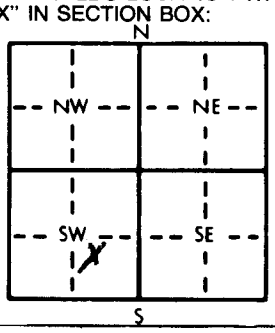

4 DEPTH OF COMPLETED WELL 31 ft. ELEVATION:
Depth(s) Groundwater Encountered 1. 18 ft. 2. ft. 3. ft.
WELL'S STATIC WATER LEVEL 18 ft. below land surface measured on mo/day/yr 8-26-84
Pump test data: Well water was 20 ft. after 2 hours pumping 12 gpm
Est. Yield 20 gpm: Well water was ft. after hours pumping gpm
Bore Hole Diameter 11 in. to 31 ft., and in. to ft.
WELL WATER TO BE USED AS: 1 Domestic 2 Irrigation 3 Feedlot 4 Industrial 5 Public water supply 6 Oil field water supply 7 Lawn and garden only 8 Air conditioning 9 Dewatering 10 Observation well 11 Injection well 12 Other (Specify below)
Was a chemical/bacteriological sample submitted to Department? Yes No ✓; If yes, mo/day/yr sample was submitted
Water Well Disinfected? Yes No

5 TYPE OF BLANK CASING USED: 1 Steel 2 PVC 3 RMP (SR) 4 ABS 5 Wrought iron 6 Asbestos-Cement 7 Fiberglass 8 Concrete tile 9 Other (specify below)
CASING JOINTS: Glued ✓ Clamped Welded Threaded
Blank casing diameter 5 in. to 18 ft., Dia in. to ft., Dia in. to ft.
Casing height above land surface 12 in., weight 2.37 lbs./ft. Wall thickness or gauge No. .250
TYPE OF SCREEN OR PERFORATION MATERIAL: 1 Steel 2 Brass 3 Stainless steel 4 Galvanized steel 5 Fiberglass 6 Concrete tile 7 PVC 8 RMP (SR) 9 ABS 10 Asbestos-cement 11 Other (specify) 12 None used (open hole)
SCREEN OR PERFORATION OPENINGS ARE: 1 Continuous slot 2 Louvered shutter 3 Mill slot 4 Key punched 5 Gauzed wrapped 6 Wire wrapped 7 Torch cut 8 Saw cut 9 Drilled holes 10 Other (specify) 11 None (open hole)
SCREEN-PERFORATED INTERVALS: From 18 ft. to 31 ft., From ft. to ft.
From ft. to ft., From ft. to ft.
GRAVEL PACK INTERVALS: From 14 ft. to 31 ft., From ft. to ft.
From ft. to ft., From ft. to ft.

6 GROUT MATERIAL: 1 Neat cement 2 Cement grout 3 Bentonite 4 Other 0-3' SURFACE SOIL
Grout Intervals: From 3 ft. to 14 ft., From ft. to ft., From ft. to ft.
What is the nearest source of possible contamination: 1 Septic tank 2 Sewer lines 3 Watertight sewer lines 4 Lateral lines 5 Cess pool 6 Seepage pit 7 Pit privy 8 Sewage lagoon 9 Feedyard 10 Livestock pens 11 Fuel storage 12 Fertilizer storage 13 Insecticide storage 14 Abandoned water well 15 Oil well/Gas well 16 Other (specify below)
Direction from well? NORTH How many feet? 35

FROM	TO	LITHOLOGIC LOG	FROM	TO	LITHOLOGIC LOG
0	3	SURFACE SOIL			
3	160	CLAY			
160	240	FINE SAND STREAKS OF CLAY			
240	250	CLAY			
250	300	FINE SAND			
300	310	CLAY			

7 CONTRACTOR'S OR LANDOWNER'S CERTIFICATION: This water well was (1) constructed, (2) reconstructed, or (3) plugged under my jurisdiction and was completed on (mo/day/year) 8-28-84 and this record is true to the best of my knowledge and belief. Kansas Water Well Contractor's License No. 437 This Water Well Record was completed on (mo/day/yr) 8-28-84 under the business name of RALPH HIRTZLER WELL DIGGER DRILLING (signature) Ralph S. Hirtzler

INSTRUCTIONS: Use typewriter or ball point pen, *PLEASE PRESS FIRMLY* and *PRINT* clearly. Please fill in blanks, underline or circle the correct answers. Send top three copies to Kansas Department of Health and Environment, Division of Environment, Environmental Geology Section, Topeka, KS 66620. Send one to WATER WELL OWNER and retain one for your records.

OFFICE USE ONLY T 28 R 1 (E) W SEC. 31 NW ¼ SE ¼ SW ¼