


1 LOCATION OF WATER WELL: County: <u>Sedgewick</u> Fraction: <u>NW 1/4 NW 1/4 NE 1/4</u> Section Number: <u>32</u> Township Number: <u>T 28 S</u> Range Number: <u>R 1 E</u>

Distance and direction from nearest town or city street address of well if located within city?

Same As Below

2 WATER WELL OWNER: <u>Willard Georing</u> RR#, St. Address, Box #: <u>400 Hollywood</u> City, State, ZIP Code: <u>Wichita, KS 67218</u>	Board of Agriculture, Division of Water Resources Application Number:
--	--

3 LOCATE WELL'S LOCATION WITH AN "X" IN SECTION BOX:	4 DEPTH OF COMPLETED WELL: <u>30'</u> ft. ELEVATION: <u>1150</u> ft.
--	--

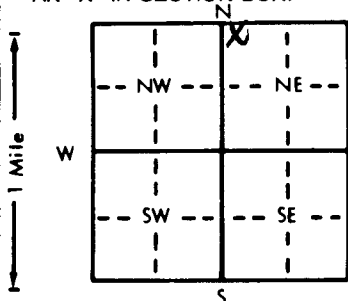

Depth(s) Groundwater Encountered: <u>12</u> ft. 2. <u>12</u> ft. 3. <u>8-9-93</u> ft.
WELL'S STATIC WATER LEVEL: <u>12</u> ft. below land surface measured on mo/day/yr
Pump test data: Well water was <u>12</u> ft. after <u>2</u> hours pumping <u>20</u> gpm
Est. Yield: <u>10</u> gpm Well water was <u>30</u> ft. after <u>2</u> hours pumping <u>20</u> gpm
Bore Hole Diameter: <u>10</u> in. to <u>30</u> ft. and <u>2</u> in. to <u>10</u> ft.
WELL WATER TO BE USED AS:
1 Domestic 3 Feedlot 5 Public water supply 8 Air conditioning 11 Injection well
2 Irrigation 4 Industrial 6 Oil field water supply 9 Dewatering 12 Other (Specify below)
7 Lawn and garden only 10 Monitoring well
Was a chemical/bacteriological sample submitted to Department? Yes <u>✓</u> No <u>✓</u> If yes, mo/day/yr sample was submitted
Water Well Disinfected? Yes <u>✓</u> No <u>✓</u>

5 TYPE OF BLANK CASING USED:	5 Wrought iron	8 Concrete tile	CASING JOINTS: Glued <u>✓</u> Clamped <u>✓</u>
1 Steel	6 Asbestos-Cement	9 Other (specify below)	Welded
2 PVC	7 Fiberglass		Threaded
3 RMP (SR)			
4 ABS			

Blank casing diameter: <u>5</u> in. to <u>20</u> ft. Dia	Blank casing diameter: <u>12</u> in. to <u>50</u> ft. Dia
Casing height above land surface: <u>12</u> in. weight <u>50</u> lbs./ft.	Casing height above land surface: <u>12</u> in. weight <u>160</u> lbs./ft.

TYPE OF SCREEN OR PERFORATION MATERIAL:	7 PVC	10 Asbestos-cement
1 Steel	8 RMP (SR)	11 Other (specify)
2 Brass	9 ABS	12 None used (open hole)
3 Stainless steel		
4 Galvanized steel		

SCREEN OR PERFORATION OPENINGS ARE:	5 Gauzed wrapped	8 Saw cut	11 None (open hole)
1 Continuous slot	6 Wire wrapped	9 Drilled holes	
2 Louvered shutter	7 Torch cut	10 Other (specify)	
3 Mill slot			
4 Key punched			

SCREEN-PERFORATED INTERVALS:	From <u>20</u> ft. to <u>30</u> ft.	From <u>12</u> ft. to <u>30</u> ft.
GRAVEL PACK INTERVALS:	From <u>12</u> ft. to <u>30</u> ft.	From <u>12</u> ft. to <u>30</u> ft.

6 GROUT MATERIAL:	1 Neat cement	2 Cement grout	3 Bentonite	4 Other
Grout Intervals:	From <u>0</u> ft. to <u>12</u> ft.	From <u>12</u> ft. to <u>30</u> ft.	From <u>12</u> ft. to <u>30</u> ft.	From <u>12</u> ft. to <u>30</u> ft.

What is the nearest source of possible contamination: <u>N/A</u>	10 Livestock pens	14 Abandoned water well
1 Septic tank	11 Fuel storage	15 Oil well/Gas well
2 Sewer lines	12 Fertilizer storage	16 Other (specify below)
3 Watertight sewer lines	13 Insecticide storage	
4 Lateral lines		
5 Cess pool		
6 Seepage pit		
7 Pit privy		
8 Sewage lagoon		
9 Feedyard		

Direction from well? How many feet?

FROM	TO	LITHOLOGIC LOG	FROM	TO	PLUGGING INTERVALS
0	2	TOP SOIL			
2	16	FINE SAND			
16	23	MED SAND			
23	30	COARSE SAND			

7 CONTRACTOR'S OR LANDOWNER'S CERTIFICATION: This water well was (1) constructed, (2) reconstructed, or (3) plugged under my jurisdiction and was completed on (mo/day/year) <u>5-9-93</u> and this record is true to the best of my knowledge and belief. Kansas Water Well Contractor's License No. <u>463</u> This Water Well Record was completed on (mo/day/year) <u>6-23-93</u> under the business name of <u>R & A</u> by (signature) <u>Daniel R. Kubit</u>
