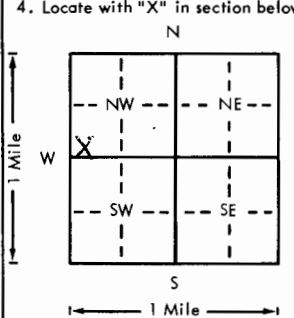


USE TYPEWRITER OR BALL
POINT PEN-PRESS FIRMLY,
PRINT CLEARLY.

WATER WELL RECORD
KSA 82a-1201-1215

Kansas Department of Health and
Environment-Division of Environment
(Water well Contractors)
Topeka, Kansas 66620

1. Location of well:		County Sedgewick	Fraction SW 1/4 SW 1/4 NW 1/4	Section number 32	Township number T 28	Range number S R 1	EW
2. Distance and direction from nearest town or city: Street address of well location if in city:		At stop light at Hayville 1 block S East		3. Owner of well: Clearwater Excavating Inc. Clearwater, Kansas 67026 City, state, zip code:			
4. Locate with "X" in section below:		Sketch map:		6. Bore hole dia. 28 in. Completion date 5/7/79 Well depth 53 ft.			
				7. Cable tool ☐ Rotary ☐ Driven ☐ Dug ☐ Hollow rod ☐ Jetted ☐ Bored ☒ Reverse rotary			
5. Type and color of material		From		To		8. Use: Domestic ☐ Public supply ☐ Industry ☐ Irrigation ☐ Air conditioning ☐ Stock ☐ Lawn ☐ Oil field water ☒ Other dewater	
Top soil		0		3		9. Casing material: Steel Above or below Threaded ☐ Welded ☒ Surface 12 in. RMP ☐ PVC ☒ Weight 30 lbs./ft. Dia. 16 in. to 23 ft. depth Wall thickness: inches or Dia. 8 in. to 23 ft. depth gauge No. 3/16	
Clay		3		8		10. Screen: Manufacturer's name Derry Metal Type Punched Dia. 16 Slot/gauze 3/16 Length 40 Set between 23 ft. and 53 ft. Gravel pack yes Size range of material 1/2 x 1/4	
Med. sand (Red) tight formation		8		12		11. Static water level: 6 ft. below land surface Date 5/7/79 mo./day/yr.	
Clay		12		16		12. Pumping level below land surfaces: 26 ft. after 1 hrs. pumping 800 g.p.m. 38 ft. after 2 hrs. pumping 850 g.p.m. Estimated maximum yield 850 g.p.m.	
Med. red sand, tight formation		16		28		13. Water sample submitted: no mo./day/yr. Yes ☐ No ☒ Date	
Med. red sand w/green clay		28		30		14. Well head completion: 12 inches above grade Pitless adapter ☐	
Med. red sand		30		53		15. Well grouted? no With: Neat cement ☐ Bentonite ☐ Concrete ☐ Depth: From 23 ft. to 53 ft.	
Green clay		53				16. Nearest source of possible contamination: ft. none Direction none Type none Well disinfected upon completion? Yes ☐ No ☒	
						17. Pump: Not installed Manufacturer's name Western Levelator Model number Stage 2 H 80 Volts 80 Length of drop pipe 50 ft. capacity 800 g.p.m. Type: ☐ Submersible ☒ Turbine ☐ Jet ☐ Reciprocating ☐ Centrifugal ☐ Other	
18. Elevation:		19. Remarks: Casing pulled + hole filled in		20. Water well contractor's certification: This well was drilled under my jurisdiction and this report is true to the best of my knowledge and belief. Rosencrantz-Bemis Ent. Inc. 134 Business name License No. Address 1211 W. 4th Hutchinson, Ks. Signed Mike Flowers Date 7-28-79 Authorized representative			

Forward the white, blue and pink copies to the Department of Health and Environment

Form WWC-5