

WATER WELL RECORD

Form WW-5

KSA 82a-1212

532

T 28 S


1 E

1 LOCATION OF WATER WELL: County: Sedgwick Fraction: NE NE NE NW Section Number: Block 1 Township Number: T 28 S Range Number: 1 E

Distance and direction from nearest town or city street address of well if located within city? 6409 COREY WICHITA, KS.

2 WATER WELL OWNER: PATRICK A. PATNAUDE RR#, St. Address, Box #: 6409 COREY Board of Agriculture, Division of Water Resources City, State, ZIP Code: WICHITA, KS. 67217 Application Number:

3 LOCATE WELL'S LOCATION WITH AN "X" IN SECTION BOX: 63rd 4 DEPTH OF COMPLETED WELL: 12 FT. ft. ELEVATION:

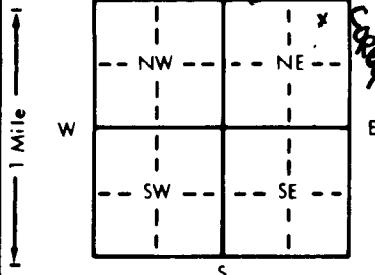

Depth(s) Groundwater Encountered 1. . . . . ft. 2. . . . . ft. 3. . . . . ft. WELL'S STATIC WATER LEVEL DRY . . . . . ft. below land surface measured on mo/day/yr 8/13/90 Pump test data: Well water was . . . . . ft. after . . . . . hours pumping . . . . . gpm Est. Yield . . . . . gpm: Well water was . . . . . ft. after . . . . . hours pumping . . . . . gpm Bore Hole Diameter . . . . . in. to . . . . . ft., and . . . . . in. to . . . . . ft. WELL WATER TO BE USED AS: 5 Public water supply 8 Air conditioning 11 Injection well 1 Domestic WAS 3 Feedlot 6 Oil field water supply 9 Dewatering 12 Other (Specify below) 2 Irrigation 4 Industrial Lawn and garden only 10 Monitoring well . . . . . Was a chemical/bacteriological sample submitted to Department? Yes . . . . . No . . . . . ; If yes, mo/day/yr sample was submitted . . . . . Water Well Disinfected? Yes . . . . . No . . . . .

5 TYPE OF BLANK CASING USED: 1 Steel 3 RMP (SR) 5 Wrought iron 8 Concrete tile CASING JOINTS: Glued . . . . . Clamped . . . . . 2 PVC 4 ABS 6 Asbestos-Cement 9 Other (specify below) Welded . . . . . Threaded . . . . .

Blank casing diameter . . . . . in. to . . . . . ft., Dia . . . . . in. to . . . . . ft., Dia . . . . . in. to . . . . . ft. Casing height above land surface 1 3/4 in. weight . . . . . lbs./ft. Wall thickness or gauge No. . . . .

TYPE OF SCREEN OR PERFORATION MATERIAL: 1 Steel 3 Stainless steel 5 Fiberglass 7 PVC 10 Asbestos-cement 2 Brass 4 Galvanized steel 6 Concrete tile 8 RMP (SR) 11 Other (specify) NA 3 None used (open hole)

SCREEN OR PERFORATION OPENINGS ARE: 1 Continuous slot 3 Mill slot 5 Gauzed wrapped 8 Saw cut 11 None (open hole) 2 Louvered shutter 4 Key punched 6 Wire wrapped 9 Drilled holes 10 Other (specify) NA 7 Torch cut

SCREEN-PERFORATED INTERVALS: From . . . . . ft. to . . . . . ft., From . . . . . ft. to . . . . . ft. GRAVEL PACK INTERVALS: From . . . . . ft. to . . . . . ft., From . . . . . ft. to . . . . . ft.

6 GROUT MATERIAL: 1 Neat cement 2 Cement grout 3 Bentonite 4 Other . . . . . Grout Intervals: From . . . . . ft. to 12 ft., From . . . . . ft. to . . . . . ft.

What is the nearest source of possible contamination: 1 Septic tank 4 Lateral lines 7 Pit privy 10 Livestock pens 14 Abandoned water well 2 Sewer lines 5 Cess pool 8 Sewage lagoon 11 Fuel storage 15 Oil well/Gas well 3 Watertight sewer lines 6 Seepage pit 9 Feedyard 12 Fertilizer storage 16 Other (specify below) 13 Insecticide storage NONE

Direction from well? FROM TO LITHOLOGIC LOG FROM TO PLUGGING INTERVALS

FROM	TO	LITHOLOGIC LOG	FROM	TO	PLUGGING INTERVALS
12	0	NEAT CEMENT			
		THE WELL WAS ON A PATIO CONCRETE SLAB, THE WELL WAS DRY. I PLUGGED ALL 12 FT. WITH NEAT CEMENT LEVEL WITH THE SLAB.			

7 CONTRACTOR'S OR LANDOWNER'S CERTIFICATION: This water well was (1) constructed, (2) reconstructed, or (3) plugged under my jurisdiction and was completed on (mo/day/year) 8/13/90 and this record is true to the best of my knowledge and belief. Kansas Water Well Contractor's License No. . . . . This Water Well Record was completed on (mo/day/yr) 8/14/90 under the business name of . . . . . by (signature) Patrick A. Patnaude