USE TYPEWRITER OR BALL POINT PEN-PRESS FIRMLY, PRINT CLEARLY.

WATER WELL RECORD
KSA 82a-1201-1215

Kansas Department of Health and Environment-Division of Environment
(Water well Contractors)
Topeka, Kansas 66620

| 1. Location of well: | County | Fraction | Section number | Township number | Range number |
|---|---|---|---|---|---|
| | Sedgwick | 1/4 NW 1/4 NW 1/4 | 35 | T 28 S | R 1E E/W |

2. Distance and direction from nearest town or city: 3329 E. 63rd S.
Street address of well location if in city: Derby, Kansas

3. Owner of well: D. E. Cook
R.R. or street: R. R. #2 Derby, Kansas
City, state, zip code:

4. Locate with "X" in section below:

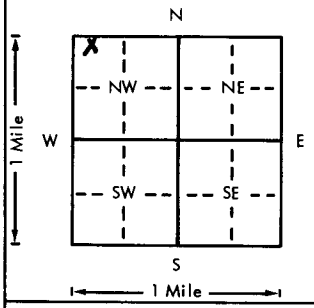


Sketch map:

6. Bore hole dia. 11 in. Completion date
Well depth 30 ft. 10-4-77

7. __ Cable tool X Rotary __ Driven __ Dug
__ Hollow rod __ Jetted __ Bored __ Reverse rotary

8. Use: X Domestic __ Public supply __ Industry
__ Irrigation __ Air conditioning __ Stock
__ Lawn __ Oil field water __ Other

9. Casing: Material styrene Height: Above or below
Threaded ___ Welded gl Surface 12 in.
RMP X PVC ___ Weight ___ lbs./ft.
Dia. 5 in. to 30 ft. depth Wall Thickness: inches or
Dia. ___ in. to ___ ft. depth gage No. .200

| 5. Type and color of material | From | To |
|---|---|---|
| Topsoil ( Sandy ) | 0 | 2 |
| Fine Sand | 2 | 14 |
| Medium Sand | 14 | 19 |
| Gray Clay and Shale | 19 | 30 |
| | | |
| | | |
| | | |
| | | |
| | | |
| | | |
| | | |
| | | |
| | | |
| | | |
| (Use a second sheet if needed) | | |

10. Screen: Manufacturer's name Sunflower Plastic
Type Styrene Dia. 5"
Slot/gauge .06 Length 15'
Set between 15 ft. and 30 ft.
___ ft. and ___ ft.
Gravel pack? yes Size range of material 1/4-1/8"

11. Static water level: mo./day/yr.
14 ft. below land surface Date 10-4-77

12. Pumping level below land surfaces:
___ ft. after ___ hrs. pumping ___ g.p.m.
___ ft. after ___ hrs. pumping ___ g.p.m.
Estimated maximum yield ___ g.p.m.

13. Water sample submitted: mo./doy/yr.
___ Yes ___ No Date

14. Well head completion: capped
___ Pitless adapter 12 Inches above grade

15. Well grouted? yes 1-2 fine sand mix
With: ___ Neat cement ___ Bentonite X Concrete
Depth: From 40" ft. to 14 ft.

16. Negrest source of possible contomination: Septic
ft. 100 Direction East Type Tank
Well disinfected upon completion? X Yes ___ No

17. Pump: X Not installed
Manufacturer's name ___
Model number ___ HP ___ Volts ___
Length of drop pipe ___ ft. capacity ___ g.p.m.
Type:
___ Submersible ___ Turbine
___ Jet ___ Reciprocating
___ Centrifugal ___ Other

18. Elevation:

Topography:
___ Hill
___ Slope
___ Upland
___ Valley

19. Remarks:
Flat Ground

20. Water well contractor's certification:
This well was drilled under my jurisdiction and this report is true to the best of my knowledge and belief.
Harp Well & Pump 236
Business name License No.
Address Wichita, Kansas
Signed M. Arnold Date
Authorized representative 10-6-77

T 28 R 1 E W Sec 35 1/4 1/4 1/4

Forward the white, blue and pink copies to the Department of Health and Environment

Form WWC-5

MI-1023