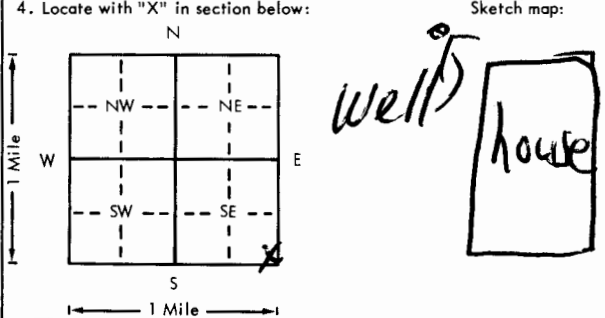


USE TYPEWRITER OR BALL
POINT PEN-PRESS FIRMLY,
PRINT CLEARLY.

WATER WELL RECORD
KSA 82a-1201-1215

Kansas Department of Health and
Environment-Division of Environment
(Water well Contractors)
Topeka, Kansas 66620

1. Location of well:	County <u>Sedgewick</u>	Fraction <u>SE 1/4 SE 1/4 SE 1/4</u>	Section number <u>35</u>	Township number <u>T 28 S</u>	Range number <u>R 1 E</u>
2. Distance and direction from nearest town or city:	3. Owner of well: <u>Callaway Const</u> R.R. or street: <u>812 No Lincoln</u> City, state, zip code: <u>Beale Plains KS</u>				
4. Locate with "X" in section below:	Sketch map:		6. Bore hole dia. <u>60</u> in. Completion date <u>10/10/79</u> Well depth <u>60</u> ft.		
			7. ☒ Cable tool ☒ Rotary ☐ Driven ☐ Dug ☐ Hollow rod ☐ Jetted ☐ Bored ☐ Reverse rotary		
5. Type and color of material	Fram		To		
<u>Top Soil</u>	<u>02</u>				
<u>red clay</u>	<u>214</u>				
<u>rocky sand</u>	<u>1454</u>				
<u>black clay</u>	<u>5460</u>				
8. Use: ☒ Domestic ☐ Public supply ☐ Industry ☐ Irrigation ☐ Air conditioning ☐ Stock ☐ Law ☐ Oil field water ☐ Other			9. Casing: Material <u>Steel</u> Height: Above or below Threaded ☐ Welded ☒ Surface <u>12</u> in. RMP ☒ PVC ☐ Weight <u>1.50</u> lb./ft. Dia. <u>5</u> in. to <u>60</u> ft. depth Wall thickness: inches or Dia. <u>5</u> in. to <u>60</u> ft. depth gage No. <u>1200</u>		
10. Screen: Manufacturer's name <u>CER-MAC</u> Type <u>200</u> Dia. <u>5 1/4</u> Slot/gauze <u>1/16</u> Length <u>20 ft</u> Set between <u>40</u> ft. and <u>60</u> ft. Gravel pack <u>yes</u> size range of material <u>3/8</u>			11. Static water level: <u>38</u> ft. below land surface Date <u>10/10/79</u> 12. Pumping level below land surfaces: <u>40</u> ft. after <u>1/2</u> hrs. pumping <u>15</u> g.p.m. <u>40</u> ft. after <u>1</u> hrs. pumping <u>15</u> g.p.m. Estimated maximum yield <u>20-25</u> g.p.m.		
13. Water sample submitted: <u>Yes</u> ☒ No ☐ Date <u>10/10/79</u>			14. Well head completion: ☒ Pitless adapter <u>12</u> inches above grade		
15. Well grouted? <u>yes</u> With: <u>Neat cement</u> ☐ Bentonite ☒ Concrete ☐ Depth: From <u>3</u> ft. to <u>13</u> ft.			16. Nearest source of possible contamination: ft. <u>None</u> Direction <u>None</u> Type <u>None</u> Well disinfected upon completion? ☒ Yes ☐ No		
17. Pump: Manufacturer's name <u>Valley</u> Model number <u>18085</u> HP <u>1/2</u> Vol <u>200</u> Length of drop pipe <u>50</u> ft. capacity <u>12</u> g.p.m. Type ☒ Submersible ☐ Turbine ☐ Jet ☐ Reciprocating ☐ Centrifugal ☐ Other			20. Water well contractor's certification: This well was drilled under my jurisdiction and this report is true to the best of my knowledge and belief. Business name <u>Callaway Const</u> License No. <u>318</u> Address <u>Sedgewick</u> Signed <u>Joe Callaway</u> Date <u>10/10/79</u> Authorized Representative		
18. Elevation:	19. Remarks: <u>Customer to furnish 4x4x4 slab around well at grade per State Regulations</u> <u>Signed Joe Callaway</u>				
Topography: ☒ Hill ☐ Slope ☐ Upland ☐ Valley					

Forward the white, blue and pink copies to the Department of Health and Environment

Form WWC-5