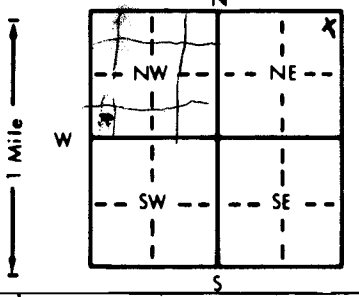


1 LOCATION OF WATER WELL:		Fraction	Section Number	Township Number	Range Number
County: <u>Sedgwick</u>		<u>N/E 1/4 N/E 1/4 N/E 1/4</u>	<u>4</u>	<u>T 28 S</u>	<u>R 1</u>
Distance and direction from nearest town or city street address of well if located within city? <u>1535 EAST PAWNEE WICHITA, KS</u>					
2 WATER WELL OWNER: <u>Fina Oil & Chemical</u>					
RR#, St. Address, Box # : <u>P.O. BOX 2159</u>			Board of Agriculture, Division of Water Resources		
City, State, ZIP Code : <u>DALLAS, TX. 75221</u>			Application Number:		
3 LOCATE WELL'S LOCATION WITH AN "X" IN SECTION BOX:		4 DEPTH OF COMPLETED WELL: <u>27.0</u> ft. ELEVATION:			
		Depth(s) Groundwater Encountered 1. ft. 2. ft. 3. ft.			
		WELL'S STATIC WATER LEVEL <u>16.0</u> ft. below land surface measured on mo/day/yr			
		Pump test data: Well water was ft. after hours pumping gpm			
		Est. Yield gpm: Well water was ft. after hours pumping gpm			
		Bore Hole Diameter <u>7.1</u> in. to <u>2.7.0</u> in. to in. to in.			
WELL WATER TO BE USED AS: 5 Public water supply 8 Air conditioning 11 Injection well					
1 Domestic 3 Feedlot 6 Oil field water supply 9 Dewatering <u>x12</u> Other (Specify below)					
2 Irrigation 4 Industrial 7 Lawn and garden only 10 Monitoring well					
Was a chemical/bacteriological sample submitted to Department? Yes.....No..... <u>sparge pnt</u>					
Water Well Disinfected? Yes.....No.....					
5 TYPE OF BLANK CASING USED:					
1 Steel		3 RMP (SR)	5 Wrought iron	8 Concrete tile	CASING JOINTS: Glued.....Clamped.....
<u>x2</u> PVC		4 ABS	6 Asbestos-Cement	9 Other (specify below)	Welded.....
			7 Fiberglass		Threaded.....
Blank casing diameter <u>2</u> in. to <u>25</u> ft., Dia. in. to ft., Dia. in. to ft.					
Casing height above land surface in., weight <u>schd. 40</u> lbs./ft. Wall thickness or gauge No.					
TYPE OF SCREEN OR PERFORATION MATERIAL:					
1 Steel		3 Stainless steel	5 Fiberglass	<u>x7</u> PVC	10 Asbestos-cement
2 Brass		4 Galvanized steel	6 Concrete tile	8 RMP (SR)	11 Other (specify)
				9 ABS	12 None used (open hole)
SCREEN OR PERFORATION OPENINGS ARE:					
1 Continuous slot		<u>x3</u> Mill slot	5 Gauzed wrapped	8 Saw cut	11 None (open hole)
2 Louvered shutter		4 Key punched	6 Wire wrapped	9 Drilled holes	
			7 Torch cut	10 Other (specify)	
SCREEN-PERFORATED INTERVALS: From <u>25</u> ft. to <u>27</u> ft., From ft. to ft.					
From ft. to ft., From ft. to ft.					
GRAVEL PACK INTERVALS: From <u>27</u> ft. to <u>24</u> ft., From ft. to ft.					
From ft. to ft., From ft. to ft.					
6 GROUT MATERIAL: <u>x1</u> Neat cement 2 Cement grout 3 Bentonite 4 Other					
Grout Intervals: From <u>24</u> ft. to <u>0.6</u> ft., From ft. to ft., From ft. to ft.					
What is the nearest source of possible contamination:					
1 Septic tank		4 Lateral lines	7 Pit privy	10 Livestock pens	14 Abandoned water well
2 Sewer lines		5 Cess pool	8 Sewage lagoon	11 Fuel storage	15 Oil well/Gas well
<u>x3</u> Watertight sewer lines		6 Seepage pit	9 Feedyard	12 Fertilizer storage	16 Other (specify below)
				13 Insecticide storage	
Direction from well? <u>south</u> How many feet? <u>60</u>					
FROM	TO	LITHOLOGIC LOG	FROM	TO	PLUGGING INTERVALS
0	0.8	concrete			
0.8	5.0	Topsoil turning to brown clay at 2.0			
5.0	10.0	brown medium clay			
10.0	15.0	tan brown clay			
15.0	20.0	tan clay turning to fine sand at 15.5 saturated at 16.5			
20.0	27.0	fine sand turning medium at 19.0 coarse from 19.0 to 27.0			
		gray/green shale at 27.0			
7 CONTRACTOR'S OR LANDOWNER'S CERTIFICATION: This water well was (1) constructed, (2) reconstructed, or (3) plugged under my jurisdiction and was completed on (mo/day/year) <u>3-8-94</u> and this record is true to the best of my knowledge and belief. Kansas Water Well Contractor's License No. <u>517</u> This Water Well Record was completed on (mo/day/yr) <u>4-6-94</u> under the business name of <u>GROUNDWATER TECHNOLOGY</u> by (signature) <u>[Signature]</u>					
INSTRUCTIONS: Use typewriter or ball point pen. PLEASE PRESS FIRMLY and PRINT clearly. Please fill in blanks, underline or circle the correct answers. Send top three copies to Kansas Department of Health and Environment, Bureau of Water, Topeka, Kansas 66620-0001. Telephone: 913-296-5545. Send one to WATER WELL OWNER and retain one for your records.					